

4037

WATER SERVICE RECORD

Name Robert Welsh

Service No. 271

Address # 8 TUETS RD., Lexington, Mass.

Location LOT # 321

~~Repair/Replace~~ New Service

Service was in

Comm. 12/31/57


Date	Material	Amount	Total	Date	Amount
12/5/57	Labor	3 71		11-18-57	Deposit
	10% Overhead	37	4 08	12-31-57	Refund
	60'-3/4" Copper tubing @.37		22 20		
	1-3/4" Cx $\frac{1}{2}$ IWH stop & waste		4 96		Non Charge
	1 hr. trucking @.75		75		1- $\frac{1}{2}$ straight tailpiece
			31 99		1- $\frac{1}{2}$ offset tailpiece
					1 00

DATE _____

TOWN OF LEXINGTON — BOARD OF PUBLIC WORKS

WATER DIVISION

Sketch of Service Here

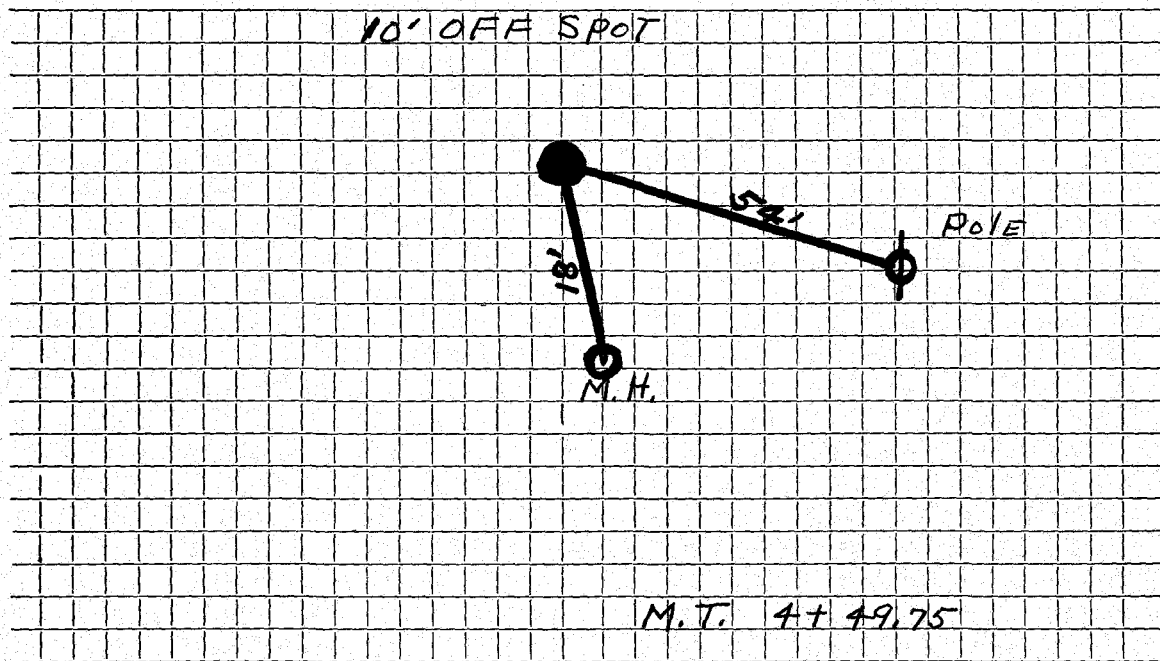

Connection made in Street. Work completed

Remarks:
.....
.....