

WATER SERVICE RECORD

Name Joseph P. Spinelli

Service No. 19

Address 9 Tufts Road

Location

~~Repair~~ ~~Repair~~ New Service

Comm 5-4-59

Date	Material	Amount	Total	Date		Amount
4-8-59	Labor	3 70		3-30-59	Deposit	25 00
	10% O. H.	37	4 07	4-21-59	Paid	69
1/4 1'	3/4" Copper Tubing @.3666		15 03			25 69
1	3/4" C x 1/2 I.W.F. Stop & Waste		5 84		NON CHARGE	
1	Hr. Trucking@.75		2 75	1/18/59	1 1/2 Straight Tailpiece	50
			25. 69		1 1/2 Offset Tailpiece	50
						1 00


Bill sent 5-4-59

.69

TOWN OF LEXINGTON — BOARD OF PUBLIC WORKS

WATER DIVISION

Sketch of Service Here

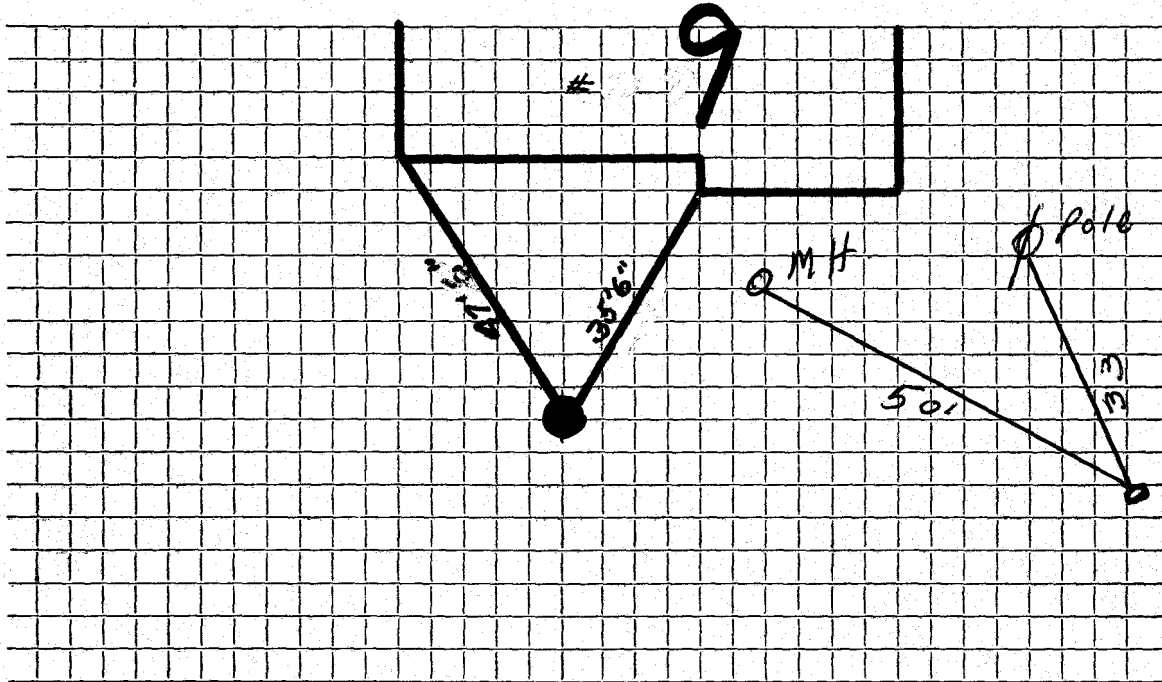

Connection made in ..... Street. Work completed .....

Remarks: .....

.....

.....