

WATER SERVICE RECORD

Name *Otis Brown*

Service No.

Address *4 TURNBERRY HILL RD.*

Location

Repair—Renewal—New Service


McLaughlin #0048

Date	Material	Amount	Total	Date	Amount
<i>10/20/89</i>	<i>29 LF 1" COPPER</i>				
	<i>1" CORP.</i>				
	<i>1" CURB</i>				

TOWN OF LEXINGTON — BOARD OF PUBLIC WORKS

WATER DIVISION

Sketch of Service Here

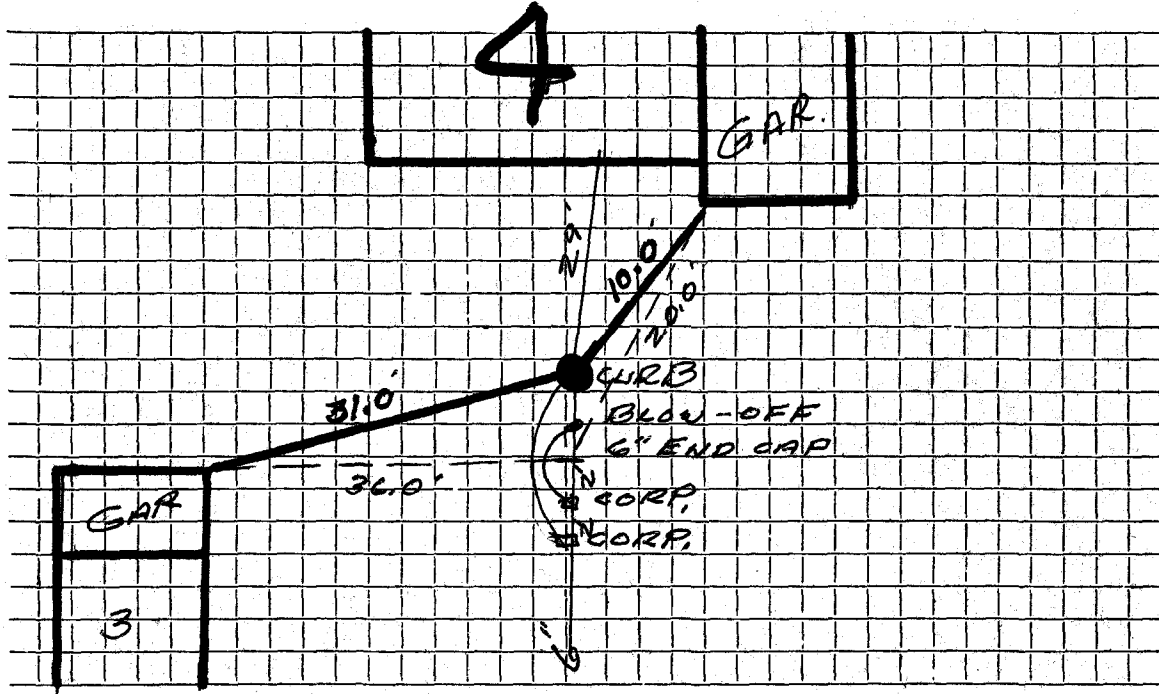

Connection made in TURNBERRY..... Street. Work completed

Remarks:
.....
.....