


TOWN OF LEXINGTON — BOARD OF PUBLIC WORKS

WATER DIVISION

Sketch of Service Here

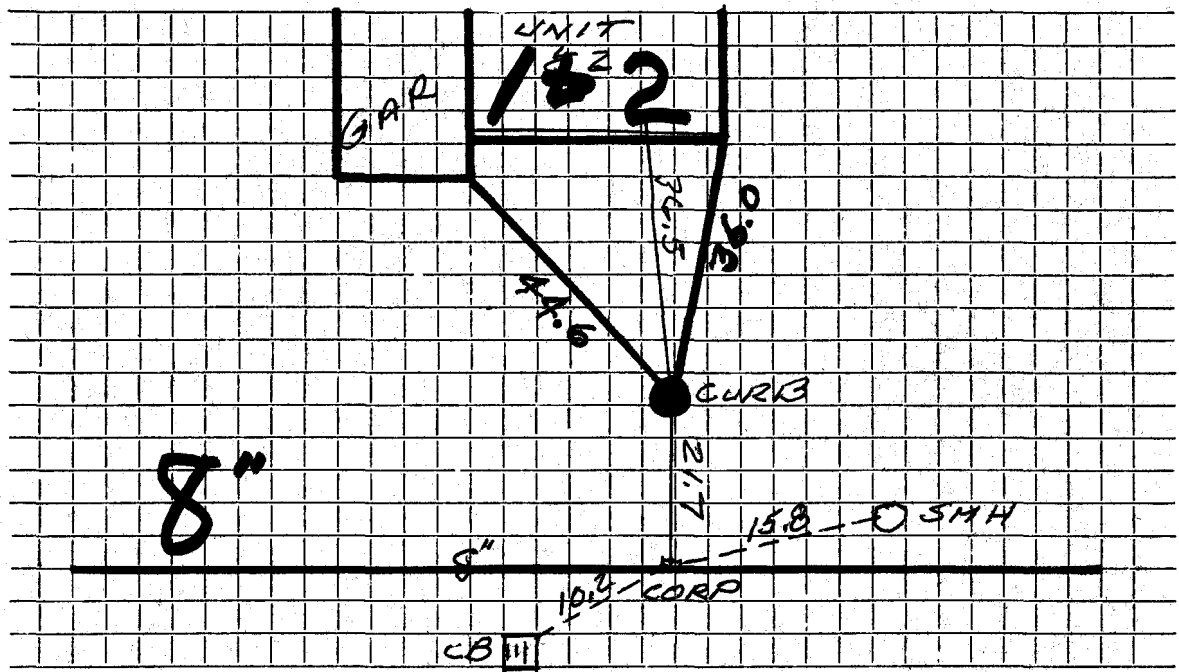

Connection made in TURNBERRY Street. Work completed

Remarks: 1 1/2\" COPPER SERV. FOR MULTI-DWELLING UNIT