

WATER SERVICE RECORD

Name Otis Brown

Service No.

Address UNIT 6 & 7 TURNBERRY HILL RD.

Location

Repair—Renewal—New Service McLaughlin #0050


Date	Material	Amount	Total	Date	Amount
6/7/89	94.7 LF 1/2" COPPER 1/2" CORP.			6-7-'89	
11/10/89	5.4 LF 1/2" COPPER 1/2" CURB			94'7" 1/2" Copper	
				1 1/2" C. Corp Cock	
				1 1/2" C. Curb Cock	

DATE _____

TOWN OF LEXINGTON — BOARD OF PUBLIC WORKS

WATER DIVISION

Sketch of Service Here

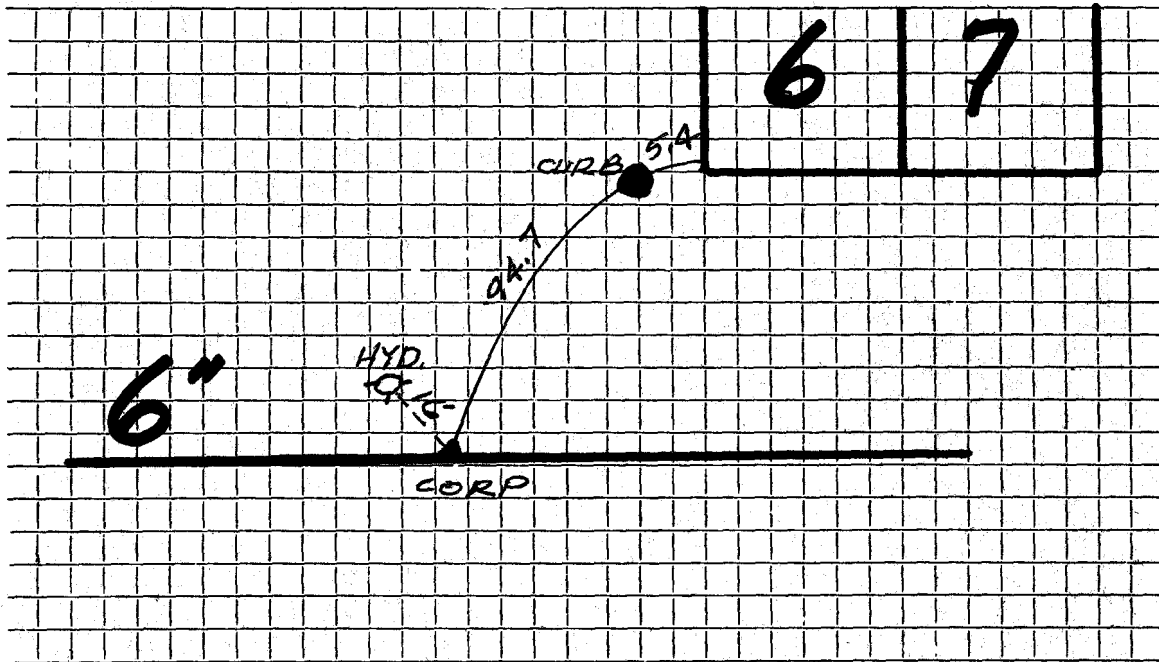

Connection made in TURNBERRY Street. Work completed

Remarks: 1 1/2" COPPER FOR MULTI-DWELLING UNIT