

## WATER SERVICE RECORD

Name Eugene Roberts

Service No. 326

Address 12 Turning Mill Road

Location


~~Repair~~ - New Service

Comm 2-8-68

Date	Material	Amount	Total	Date	Amount
10-16-59	Labor	1 85		12-15-60	100 00
	10% O. H.	19	2 04	2-8-68	5 33
	9' 3/4" Copper tubing @.41		3 69		94 67
	1 Hr. Trucking @.75		75		
			6 48	10-16-59	2 01
	BILL WHEN CONNECTED				
				7' 3/4" Copper tubing @.41	2 87
12-11-59	Labor	19.52		1 3/4" C Corp Cock	4 64
	10% O.H.	1.95	21.47	1 3/4" C Curb Cock	5 94
	115' 3/4" Copper tubing @.42		48.30	1 Box & Rod	5 00
	1 3/4"C x 1/2 I.W.J.H. Stop & Waste		5.88		20 46
	2 3/4"C 3 part union @2.27		4.54	1 1/2 Straight tailpiece	.50
	1 hr. Town Shovel @6.50		6.50	1 1/2 Offset tailpiece	.50
	2 hrs. Trucking @.75		1.50		21.46
			94.67		

TOWN OF LEXINGTON — BOARD OF PUBLIC WORKS  
WATER DIVISION

Sketch of Service Here

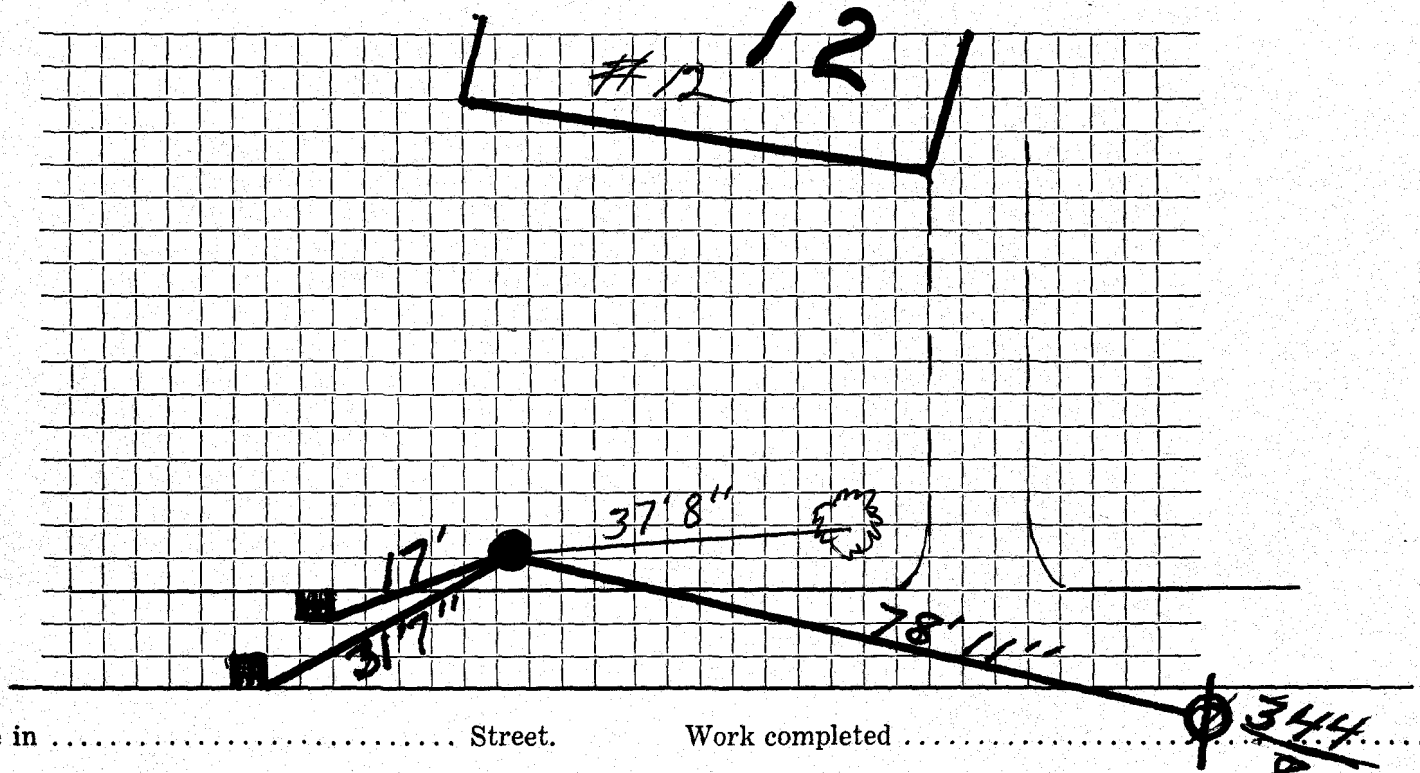

Connection made in ..... Street. Work completed .....  $\textcircled{X}$  344/8 .....

Remarks: .....  
.....  
.....