

WATER SERVICE RECORD

Name Eugene C. Roberts

Service No. 12

Address 13A Turning Mill Road

Location

~~Repair - General~~ New Service

Comm 5-8-61


Date	Material	Amount	Total	Date	Amount	
3-31-61	Labor	6.00		3-28-61	Deposit	75.00
	10% O.H.	.60	6.60	5-8-61	Paid by W.H.C. #13	6.80
140	3/4" Copper tubing @.42		58.80			81.80
1	3/4" C x 1/2 I.W.H. Stop & Waste		6.17		NON CHARGE	
3	3/4" 3 part unions @2.41		7.23	1	1/2 Straight tailpiece	.50
1	hr. Trucking @3.00		3.00	1	1/2 Offset tailpiece	.50
			81.80			1.00

DATE _____

TOWN OF LEXINGTON — BOARD OF PUBLIC WORKS

WATER DIVISION

Sketch of Service Here

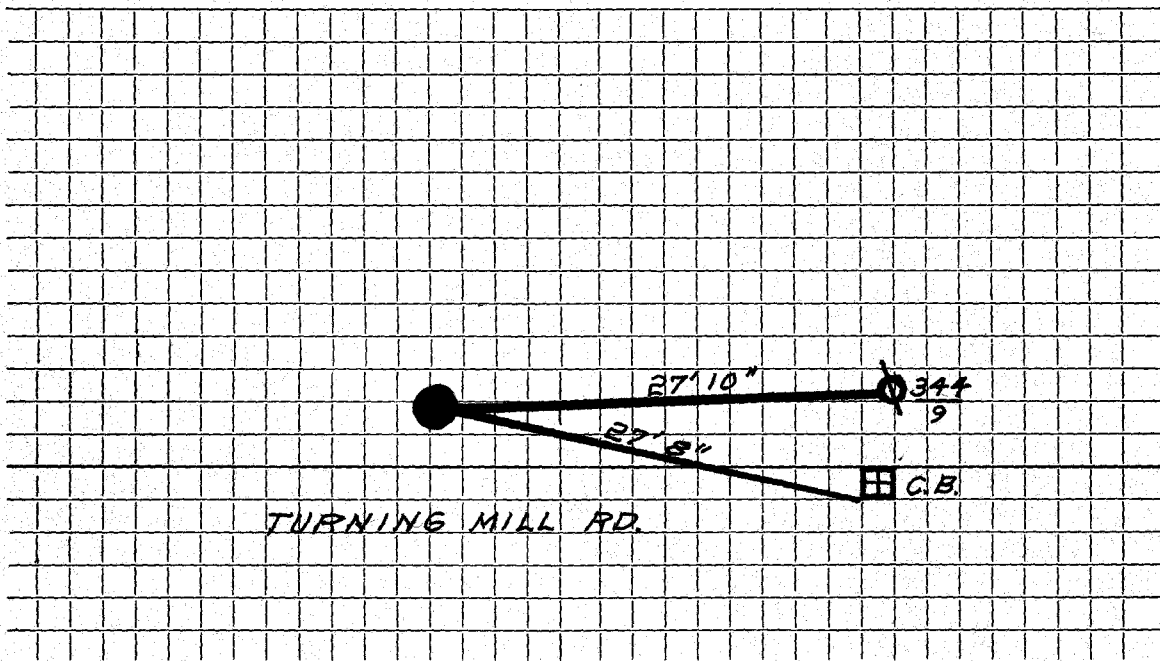

Connection made in Street. Work completed

Remarks:

.....

.....