

WATER SERVICE RECORD

2652

Name William Schreiber

Service No. 164

Address 18 Turning Mill Road

Location Lot 57 Sta. 15+49

~~REPLACEMENT~~ New Service


Comm 9-19-60

Date	Material	Amount	Total	Date		Amount
8-16-60	Labor	18.66		9-19-60	Deposit	150.00
	10% O.H.	1.87	20.53	5-11-60	Revised	72.15
97	3/4" Copper tubing @.42		40.74			72.85
1	3/4" C x 1/2 I.W.H. Stop & Waste		6.17		NON CHARGE	
1	3/4" C 3 part union		2.41	1	1/2 Straight tailpiece	.50
1	hr. Trucking @3.00		3.00	1	1/2 Offset tailpiece	.50
			72.85			1.00
				8-12-60	Labor	5.78
				9'	3/4" Copper tubing @.42	3.78
				1	3/4" C Corp Cock	4.91
				1	3/4" C Curb Cock	6.28
				1	Box & Rod	4.90
						26.65

TOWN OF LEXINGTON — BOARD OF PUBLIC WORKS

WATER DIVISION

Sketch of Service Here

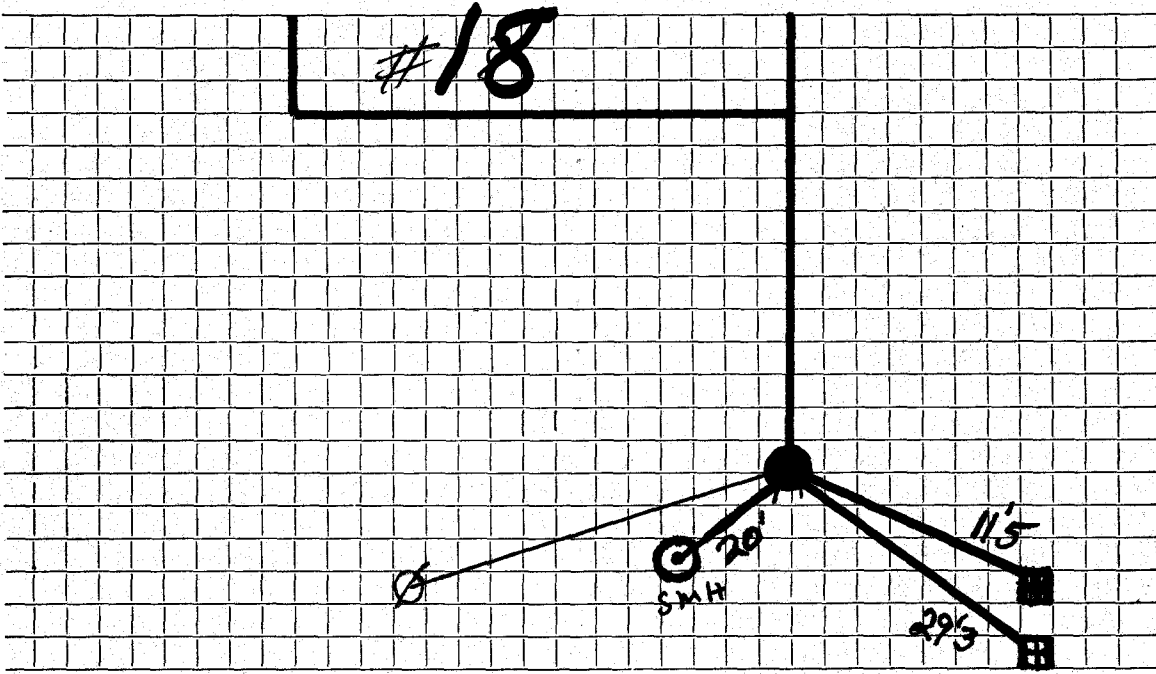

Connection made in Street. Work completed

Remarks:
.....
.....