

WATER SERVICE RECORD

Name **Eugene C. Roberts**

Service No. **79**

Address **20 Turning Mill Road**

Location **Lot #56 Sta. 15+71**


~~Work Order~~ **New Service**

Comm **7-17-61**

Date	Material	Amount	Total	Date		Amount
6-14-61	Labor	4.38		6-8-61	Deposit	25.00
	10% O.H.	.44	4.82	8-22-61	Paid	15.21
	170' 3/4" Copper Tubing @.42		71.40			90.21
	1 3/4" C x 1/2 I.W.H. Stop & Waste	6.17			NON CHARGE	
	2 3/4" C3 part union @2.41	4.82		8-12-60	Labor	4.50
	1 Hr. Trucking @3.00	3.00			7' 3/4" Copper tubing @.42	2.94
			90.21		1 3/4" C Corp Cock	4.91
					1 3/4" C Curb Cock	6.28
					1 Box & Rod	4.90
						23.53
					1 1/2 Straight tailpiece	.50
					1 1/2 Offset tailpiece	.50
						24.53
				7-17-61	Bill sent	15.21

TOWN OF LEXINGTON — BOARD OF PUBLIC WORKS
WATER DIVISION

Sketch of Service Here

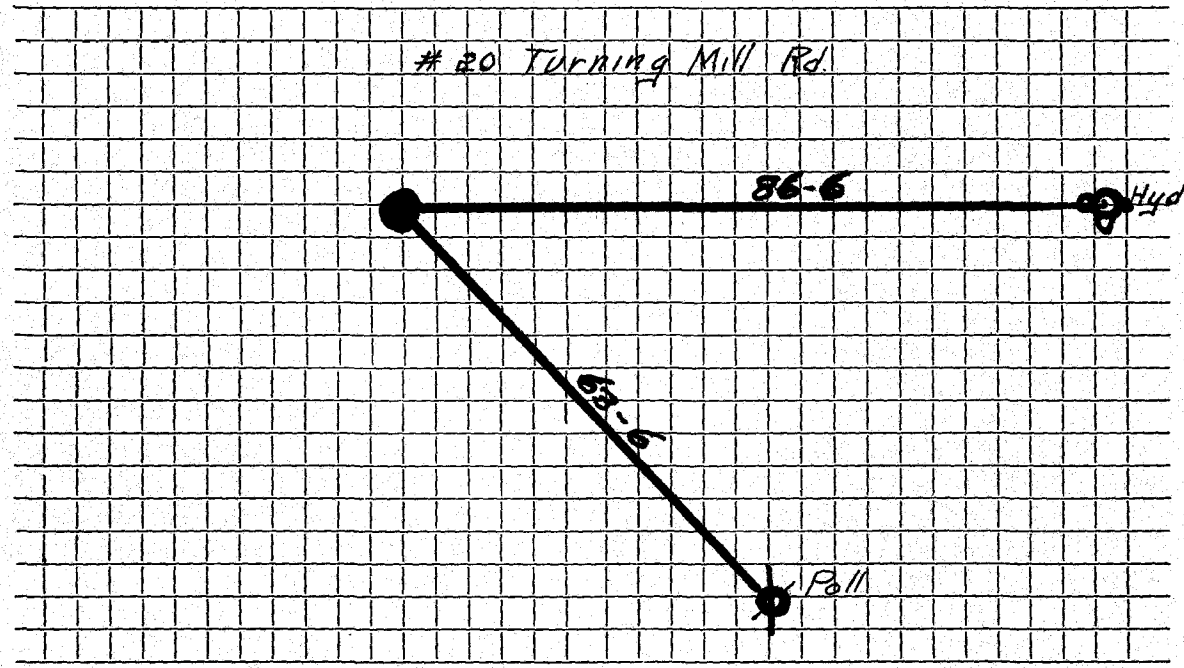

Connection made in Street. Work completed

Remarks:
.....
.....