

WATER SERVICE RECORD

3840
4378

Service No. 13

Name Eugene C. Roberts

Address 23 Turning Mill Road

Location Lot #47 Sta. 20+54

~~Repair - Renewal~~ - New Service


Comm 5-8-61

Date	Material	Amount	Total	Date		Amount
3-30-61	Labor	4.00		3-28-61	Deposit	50.00
	10% O.H.	.40	4.40	3-8-61	A Refund	8.22
60'	3/4" Copper tubing @.42		25.20			41.18
1	3/4" C x 1/2 I.W.H. Stop & Waste		6.17		NON CHARGE	
1	3/4" C 3 part union		2.41	8-12-60	Labor	16.08
1	hr. Trucking @3.00		<u>3.00</u>	25'	3/4" Copper tubing @.42	10.50
			41.18	1	3/4" C Corp Cock	4.91
				1	3/4" C Curb Cock	6.28
				1	Box & Rod	<u>4.90</u>
						42.67
				1	1/2 Straight tailpiece	50
				1	1/2 Offset tailpiece	<u>50</u>
						43.67
					A Apply 6.80 to W.C.C. #12	
					A 2.42 " " #36	

TOWN OF LEXINGTON — BOARD OF PUBLIC WORKS

WATER DIVISION

Sketch of Service Here

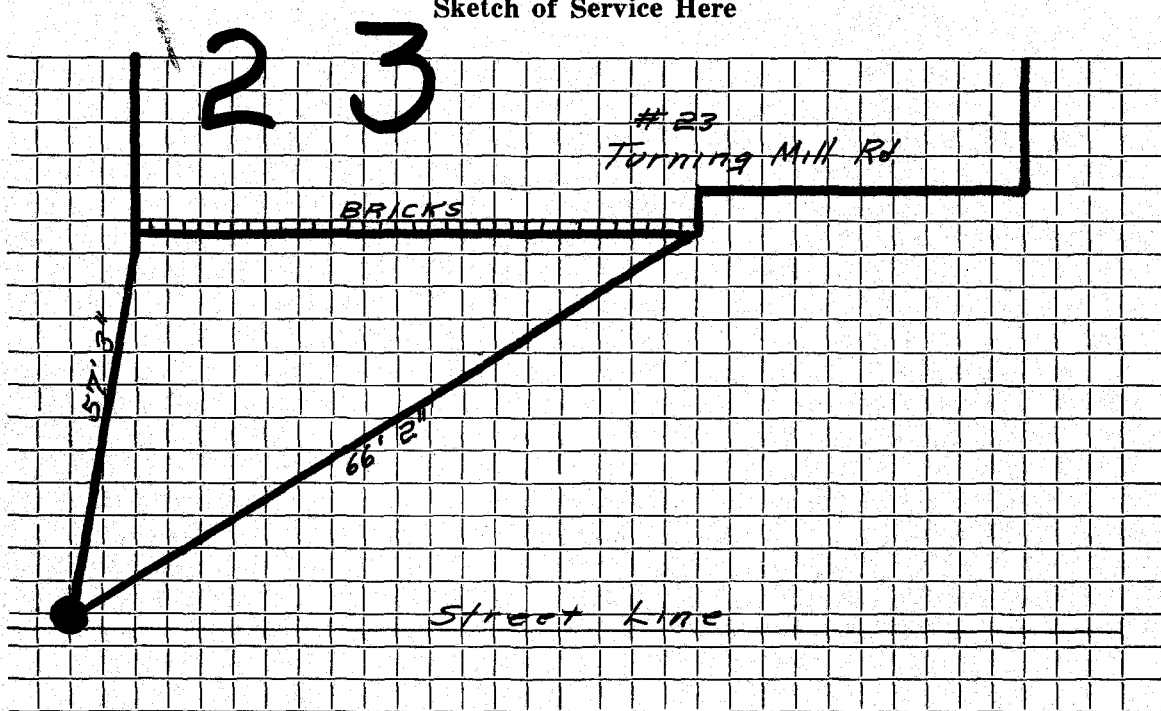

Connection made in Street. Work completed

Remarks:
.....
.....