

WATER SERVICE RECORD

Name Eugene C. Roberts
 Address 26 Turning Mill Road

Service No. 33

Location Lot #53 Sta 22+62


~~REPAIR~~ New Service

Comm 6-19-61

Date	Material	Amount	Total	Date		Amount
4-20-61	Labor	8.00		4-7-61	Deposit	75.00
	10% O.H.	.80	8.80	6-19-61	Paid by W.H.# 32	37.20
	200' 3/4" Copper Tubing @.42		84.00			112.20
	1 3/4" C x 1/2" I.W.H. Stop & Waste		6.17		NON CHARGE	
	3 3/4" C 3 part union @2.41		7.23	8-15-60	Labor	4.50
	2 Hrs. Trucking @3.00		6.00	7'	3/4" Copper tubing @.42	2.94
6-19-61	Repair		112.20	1	3/4" C Corp Cock	4.91
	11' 3/4" Copper			1	3/4" C Curb Cock	6.28
	1 3/4" C. X 1/2" I.W.H. Stop & Waste			1	Box & Rod	4.90
	1 3/4" C. 3 Part Union					23.53
				1	1/2" Straight tailpiece	.50
				1	1/2" Offset tailpiece	.50
						24.53

TOWN OF LEXINGTON — BOARD OF PUBLIC WORKS
WATER DIVISION

Sketch of Service Here

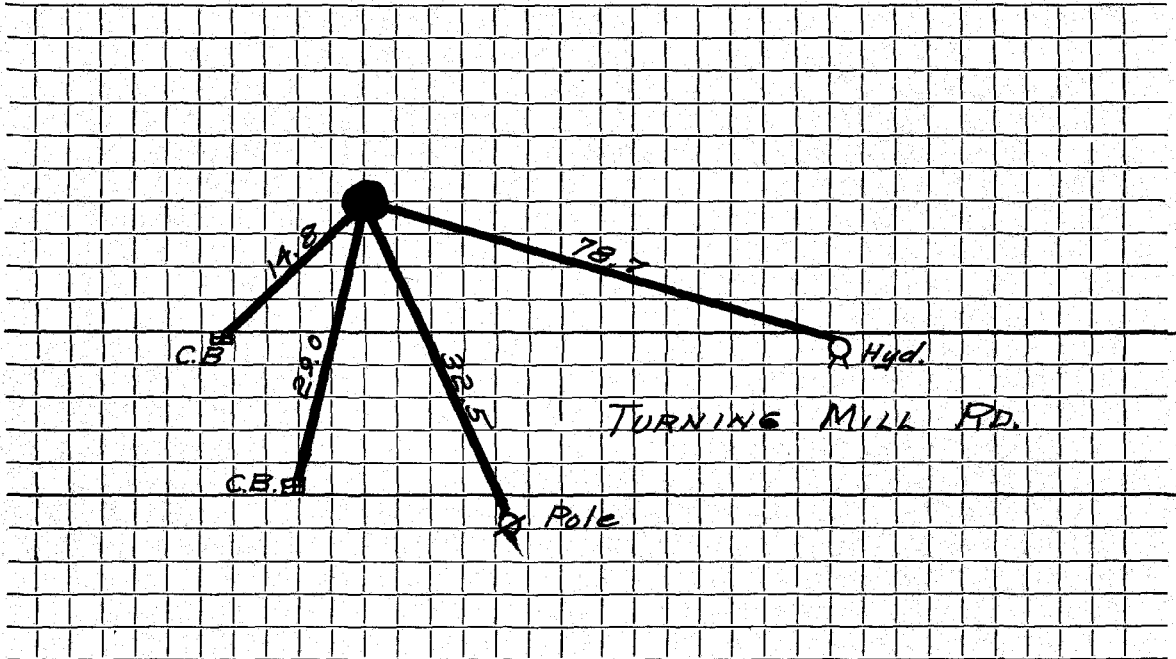

Connection made in Street. Work completed

Remarks:
.....
.....