

WATER SERVICE RECORD

Name Holiday Homes

Service No. 31

Address 27 Turning Mill Road

Location Lot #49 Sta. 25+50

~~Residence Renewal~~ - New Service Russell Sibley Permit #260


AUG 9 1965

Date		Material	Amount	Total	Date		Amount
7-14-65	85'	3/4" Copper tubing			4-21-65	Deposit	12.67
						NON CHARGE	
					8-15-60	Labor	16.08
						25' 3/4" Copper tubing @.42	10.50
						1 3/4" C Corp Cock	4.91
						1 3/4" C Cirb Cock	6.28
						1 Box & Rod	4.90
							42.67
						NON-CHARGE	
						Repair broken service	
					12-7-74	2 Hrs. Labor	
						1 3/4" Corporation	
						1 3 part union	

TOWN OF LEXINGTON — BOARD OF PUBLIC WORKS

WATER DIVISION

Sketch of Service Here

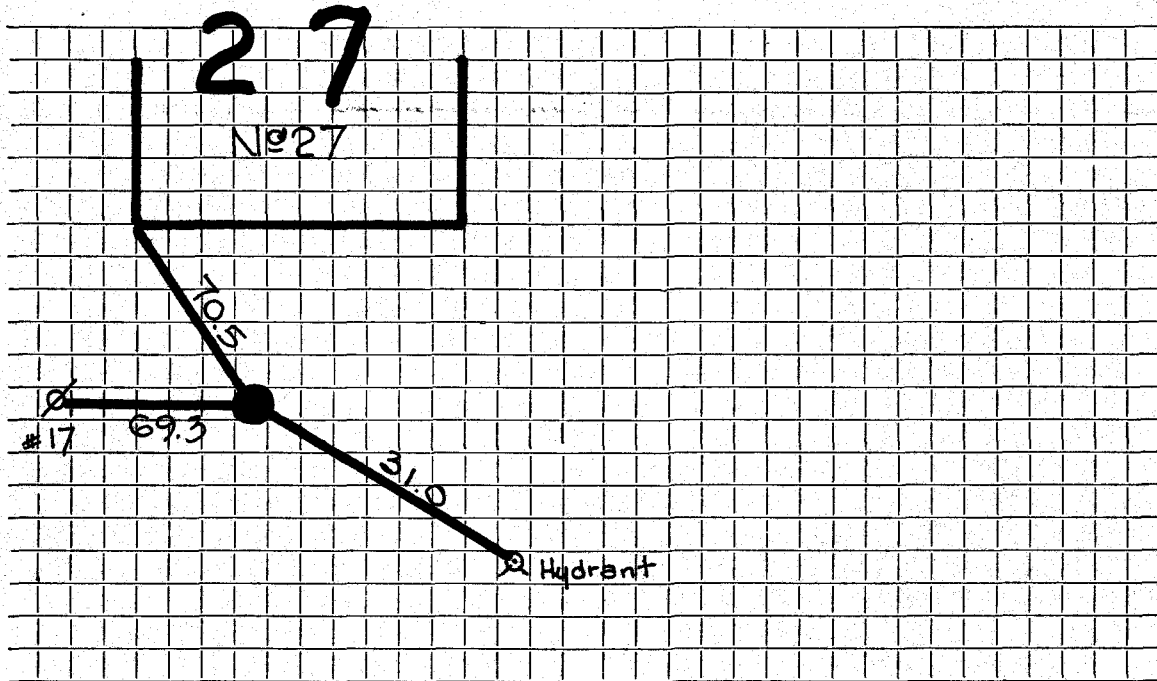

Connection made in Street. Work completed

Remarks:

.....

.....