


## WATER SERVICE RECORD

Name Eglitis ConstructionService No. 53Address 28 Turning Mill RoadLocation Lot #52 Sta. 24+15~~XXXXXXXXXX~~ New ServiceComm 6-19-61

Date	Material	Amount	Total	Date	Amount	
5-29-61	Labor	31.36		4-28-61	Deposit	125.00
5-25-61	Labor	16.18	47.54	7-16-61	Paid	9.35
	10% O.H.	4.75	52.29			134.35
9 1/4'	3/4" Copper Tubing @.42		39.48		NON CHARGE	
1	3/4" c x 1/2 I.W.H. Stop & Waste		6.17	8-15-60	Labor	5.14
1	3/4" c 3 part union		2.41	8'	3/4" Copper tubing @.42	3.36
5	Hrs. pippin Shovel @5.00		25.00	1	3/4" C Corp Cock	4.91
3	Hrs. Trucking @3.00		9.00	1	3/4" C Curb Cock	6.28
			134.35	1	Box & Rod	4.90
				1	hr. Trucking @3.00	3.00
						27.59
				5-29-61	1 1/2 Straight tailpiece	.50
					1 1/2 Offset tailpiece	.50
						28.59
				6-19-61	Bill sent	9.35

TOWN OF LEXINGTON — BOARD OF PUBLIC WORKS  
WATER DIVISION

Sketch of Service Here

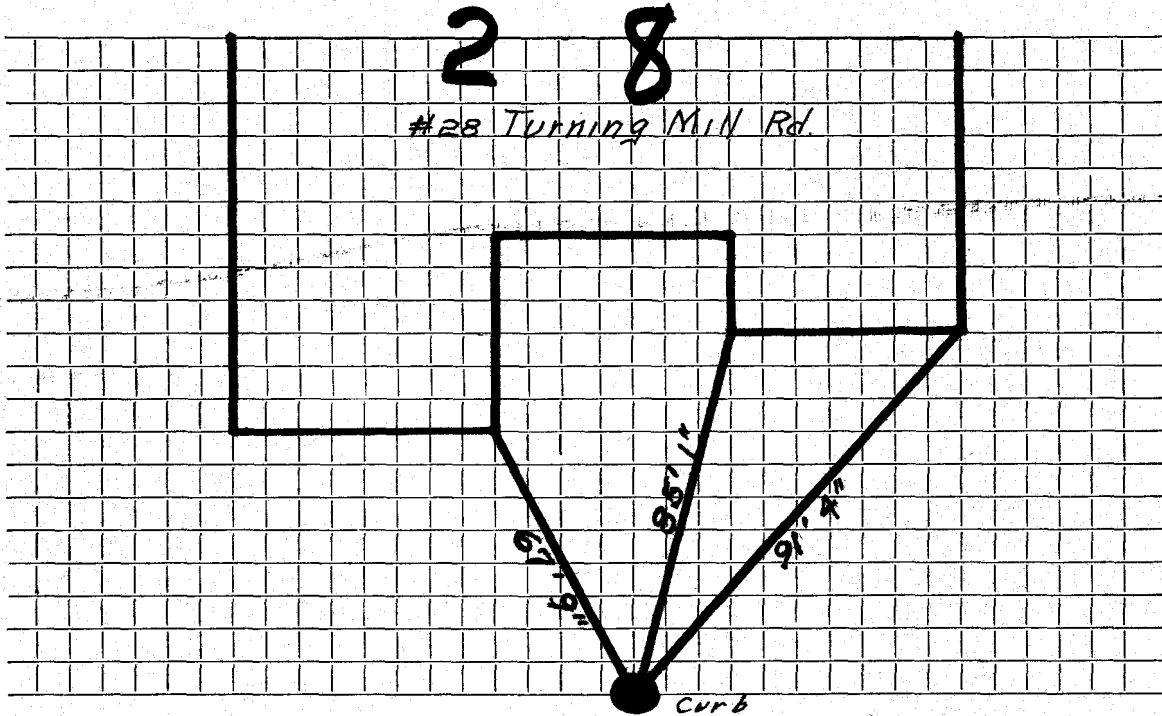

Connection made in ..... Street. Work completed .....

Remarks: .....  
.....  
.....