

**WATER SERVICE RECORD**

Name

Service No.

Address

Location **3 Turning Mill Road**

Repair—Renewal—New Service


Date	Material	Amount	Total	Date	Amount
12-28-	'72'				
	41' 3/4" Copper				
	1 3/4" C. X 1/2" L.W.H. STop + Waste			12-13-	'72'
					27' 3/4" Copper
					1 3/4" C. Corp Cock
					1 3/4" C. Curb Cock
					1 Box + Rod

DATE \_\_\_\_\_

TOWN OF LEXINGTON — BOARD OF PUBLIC WORKS

WATER DIVISION

Sketch of Service Here

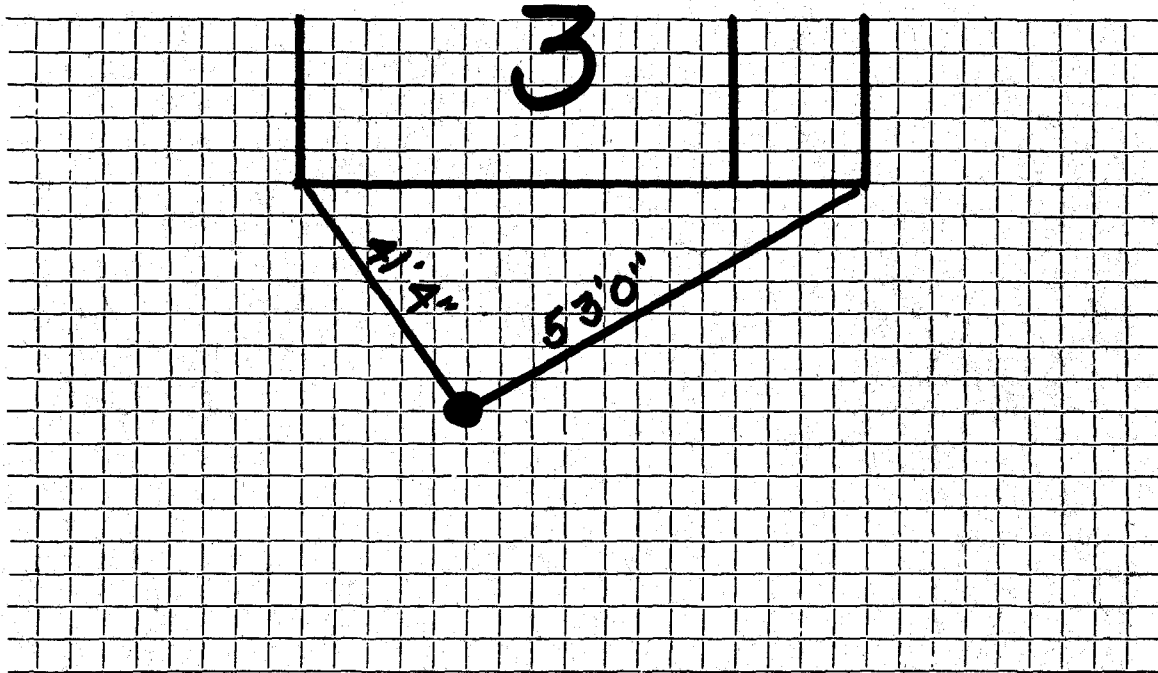

Connection made in ..... Street. Work completed .....

Remarks: *Original Service 7-31-56* .....