

WATER SERVICE RECORD

Name Sterling Builders Corp.

Service No. 274

Address 31 Turning Mill Road

(1958)

Location LOT 29

~~REPAIRS~~ New Service


Comm 6-1-59

Date	Material	Amount	Total	Date	Amount
4-23-59	Labor	8.40		12-3-58	Deposit 130.00
	10% O.H.	.84	9.24	6-12-59	Paid 26.47
240'	1" Copper tubing @.5202		124.85		156.47
	1" C x 1" I.W.H. Stop & Waste		6.59		NON CHARGE
4	1" C 3 part unions @3.76		15.04		Labor 25.05
1	hr. Trucking @.75		.75	40'	1" Copper tubing@.5202 20.81
			156.47	1	1" C Corp Cock 7.06
				1	1" C Curb Cock 7.64
				1	Box & Rod 5.00
				1	1" Straight tailpiece .93
				1	1" Offset tailpiece .93
				3	hrs Pippin Backhoe @4.50 13.50
				2	hrs. Trucking @.75 1.50
				1	hr. Compressor @3.00 3.00
					85.42
				Bill sent 6-1-59	26.47

DATE \_\_\_\_\_

**TOWN OF LEXINGTON — BOARD OF PUBLIC WORKS**  
**WATER DIVISION**

Sketch of Service Here

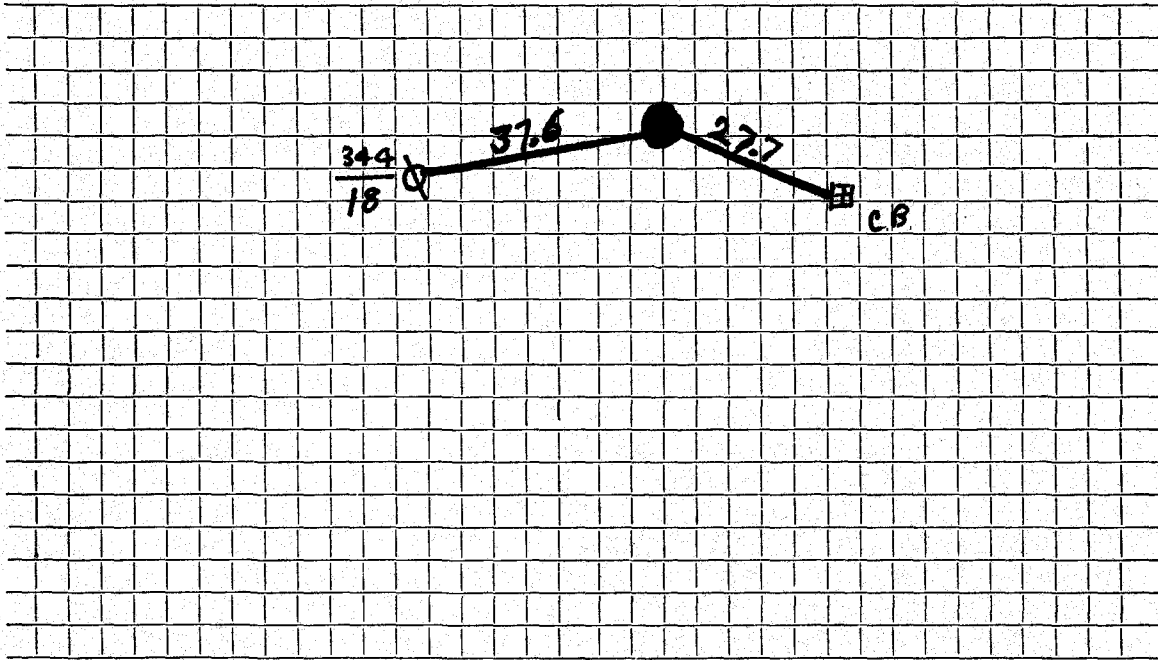

Connection made in ..... Street. Work completed .....

Remarks: .....  
.....  
.....