

## WATER SERVICE RECORD

Name Sterling Builder Corp.

Service No. 198

Address 32 Turning Mill

#1896, 7742

Location LAT 30


~~Repair - Amount~~ - New Service

Comm 12-15-58

Date	Material	Amount	Total	Date	Amount
10/1/58	Labor	10 86		9-18-58	Deposit 50 00
	10% Overhead	1 09	11 95	12-15-58	Retained 2.3 27
	16' 3/4" Copper Tubing @ .37	5 92			26 73
	1 3/4" C x 1/2 IWH Stop & Waste	5 84			NON CHARGE
	1 3/4" C 3 part Union	2 27			Service was in to Curb
	1 hr. Trucking @ .75		75	10/1/58	1 1/2 Offset Tailpiece 50
			26 73		1 1/2 Straight Tailpiece 50
					1 00
					Non-Charge
					Repair broken service
				11-27-74	2 Hrs. Labor
					4' 3/4" Copper tubing
					1 3/4" Corporation
					1 3 part union

**TOWN OF LEXINGTON — BOARD OF PUBLIC WORKS**  
**WATER DIVISION**

Sketch of Service Here

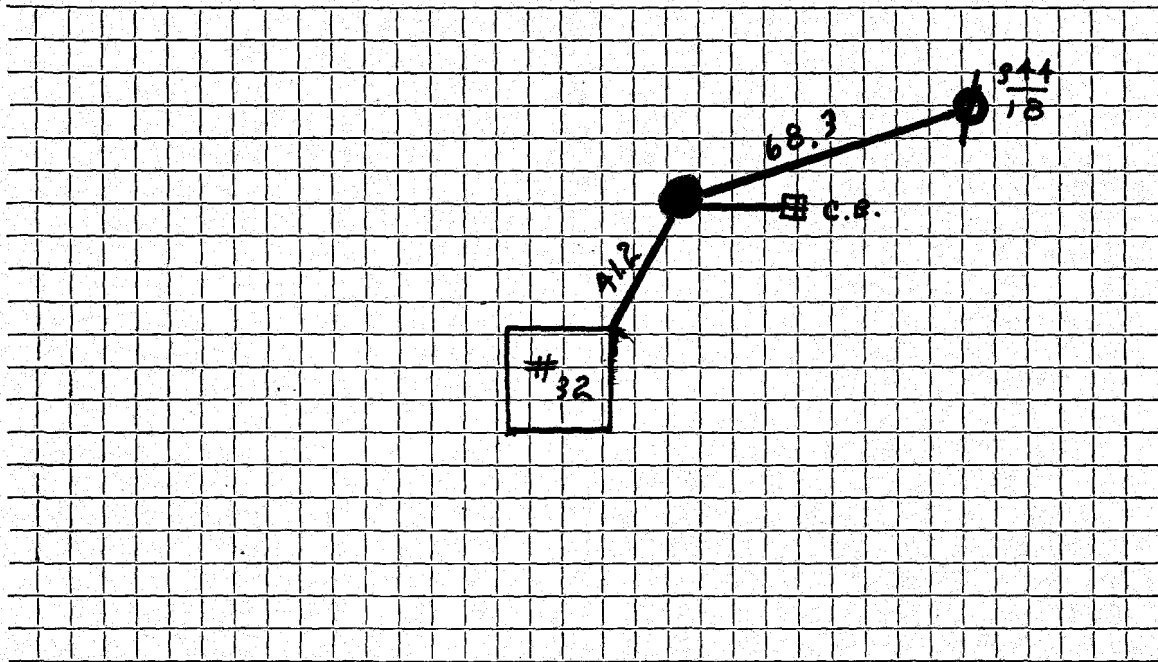

Connection made in ..... Street.                      Work completed .....

Remarks: .....  
.....  
.....