

#6684

WATER SERVICE RECORD

Name Sterling Builders Corp.

Service No. 227

Address 34 Turning Mill Road

#2246

Location Lot 31

Comm. 2/16/59

~~Repair~~—~~Renewal~~—New Service

SERVICE WAS IN


Date	Material	Amount	Total	Date	Amount
11/20/58	Labor	7 82		10/28/58	Deposit \$ 60 00
	10% overhead	78	8 60	2/16/59	Blfund 20 34
	60' - 3/4" Copper tubing @ .37		22 20		\$ 39 66
	1 - 3/4" Cx 1/2 I.W.H. Stop & Waste		5 84		NON CHARGE
	1 - 3/4" C. Union (3 part)		2 27	1 - 1/2 Offset tailpiece	50
	1 hr. Trucking		75	1 - Straight tailpiece	50
			<u>39 66</u>		<u>1 00</u>

DATE _____

TOWN OF LEXINGTON — BOARD OF PUBLIC WORKS

WATER DIVISION

Sketch of Service Here

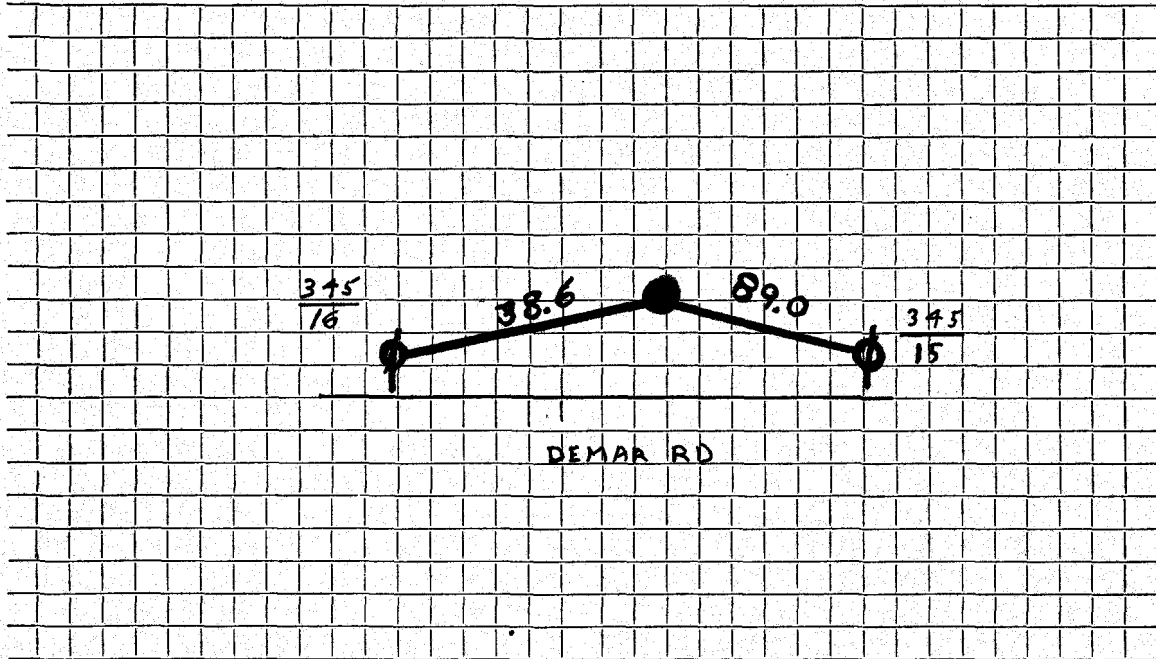

Connection made in .. DEMAR RD. Street. Work completed

Remarks:

.....

.....