

WATER SERVICE RECORD

#5115

Name Sterling Builders

Service No. 22

Address 36 Turning Mill Road

Location LOT 3

Repair—Renewal—New Service

Comm. 6-2-58


Date	Material	Amount	Total	Date	Amount
2/27/58	Labor	3 73		2-27-58	Deposit 75 00
	10% overhead	37	4 10	6-2-58	Refund 50 58
	66' - 3/4" Copper tubing @ .37		24 42		NON CHARGE \$ 24 42
	1 - 3/4" Cx 1/2 I.W.H. Stop & Waste		4 96		1 - 1/2 Straight tailpiece 50
	1 hr. Trucking		75		1 - 1/2 Offset tailpiece 50
	1 - 3/4" C. Union (3 part)		2 27		
			24 42		

DATE _____

TOWN OF LEXINGTON — BOARD OF PUBLIC WORKS

WATER DIVISION

Sketch of Service Here

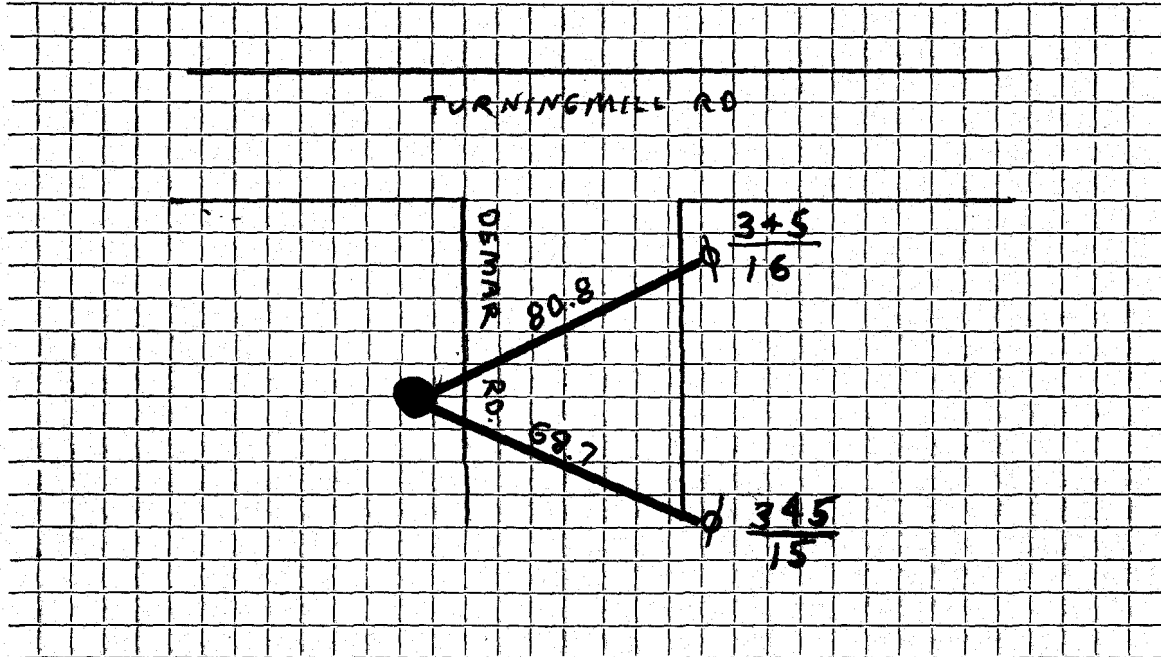

Connection made in Street. Work completed

Remarks:

.....

.....