

## WATER SERVICE RECORD

Name Lawrence Butler

Service No.

Address 37 Turning Mill Rd

Location

Repair—Renewal—New Service WO#4235 Valeri #2946


AUG 16 1976

Date	Material	Amount	Total	Date	Amount
	NON CHARGE				
5/15/76	Labor	119.46			
5/26/76	""""	69.30	188.76		
	20' 3/4" Copper tubing @.65		13.00		
	1 3/4" 3 part union		4.69		
	1 3/4" corp		10.53		
	3 gds grauel 2.19		6.57		
	2 tons stone 3/4 3.50		7.00		
	3 tons cold patch 13.50		41.10		
	2 hr. Town shovel @ 6.50		13.00		
	6 hr. trucking @ 3.00		18.00		
	1 hr. loader 4.00		4.00		
	1 hr. compressor 5.00		5.00		
	1 hr. Roller		1.00		
			<u>312.65</u>		
4/8/76	63' 3/4" Copper Tubing				

TOWN OF LEXINGTON — BOARD OF PUBLIC WORKS

WATER DIVISION

Sketch of Service Here

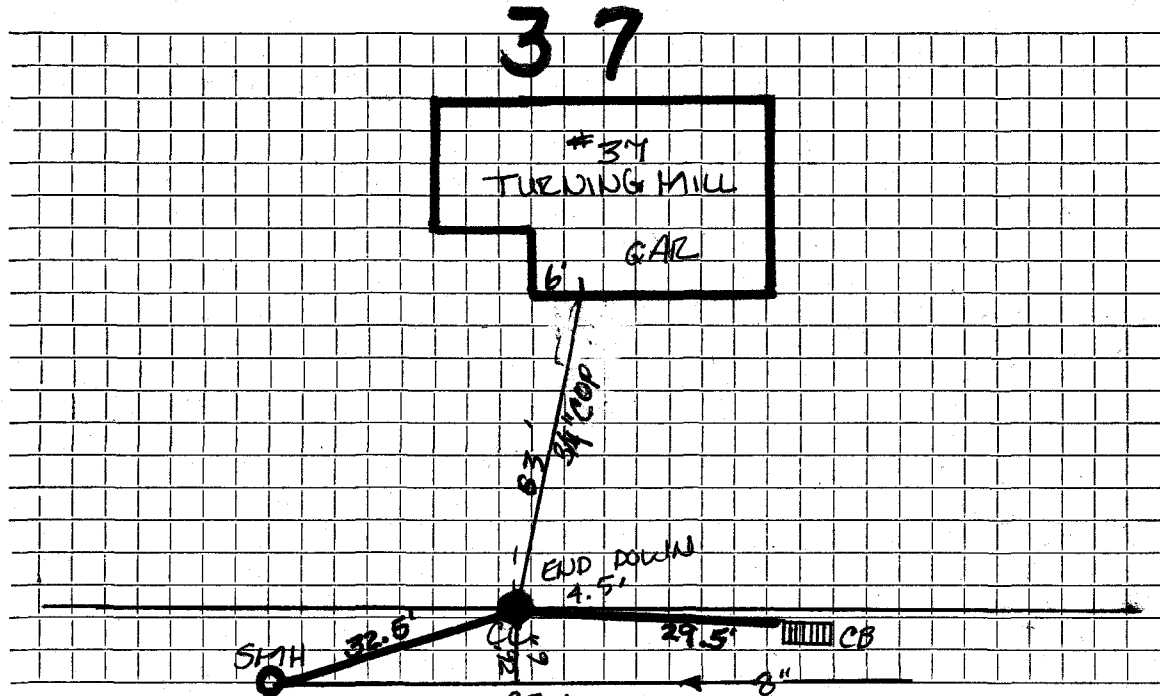

Connection made in .TURNING MILL RD.... Street. Work completed ...4-8-76.....

Remarks: .....

.....

.....