

WATER SERVICE RECORD

6147
6148

Name Sterling Builders

Service No. 23

Address 38 Turning Mill Road

Location Lot A

Repair—Renewal—New Service

Comm. 6-2-58


Date	Material	Amount	Total	Date	Amount
3/19/58	Labor	14 16		2-27-58	Deposit \$ 100 00
	10% overhead	1 42	15 58	6-2-58	Refund 17 92
	150' - 3/4" Copper tubing @ .37		55 50		\$ 82 08
	1 - 3/4" Cx 1/2 I.W.H. Stop & Waste		4 96		NON CHARGE
	2 hrs. Trucking @ .75		1 50	1 - 1/2	Straight tailpiece 50
	2 - 3/4" C. Unions (3 part) @ 2.27		4 54	1 - 1/2	Offset tailpiece 50
9/16/77	Repair W.O. #5746		82 08		1 00
	1' 3/4" Copper				
	1 3/4" Union				
	Patch Sidewalk 4' x 13'				
	Patch Driveway 10' x 19'				

DATE _____

TOWN OF LEXINGTON — BOARD OF PUBLIC WORKS

WATER DIVISION

Sketch of Service Here

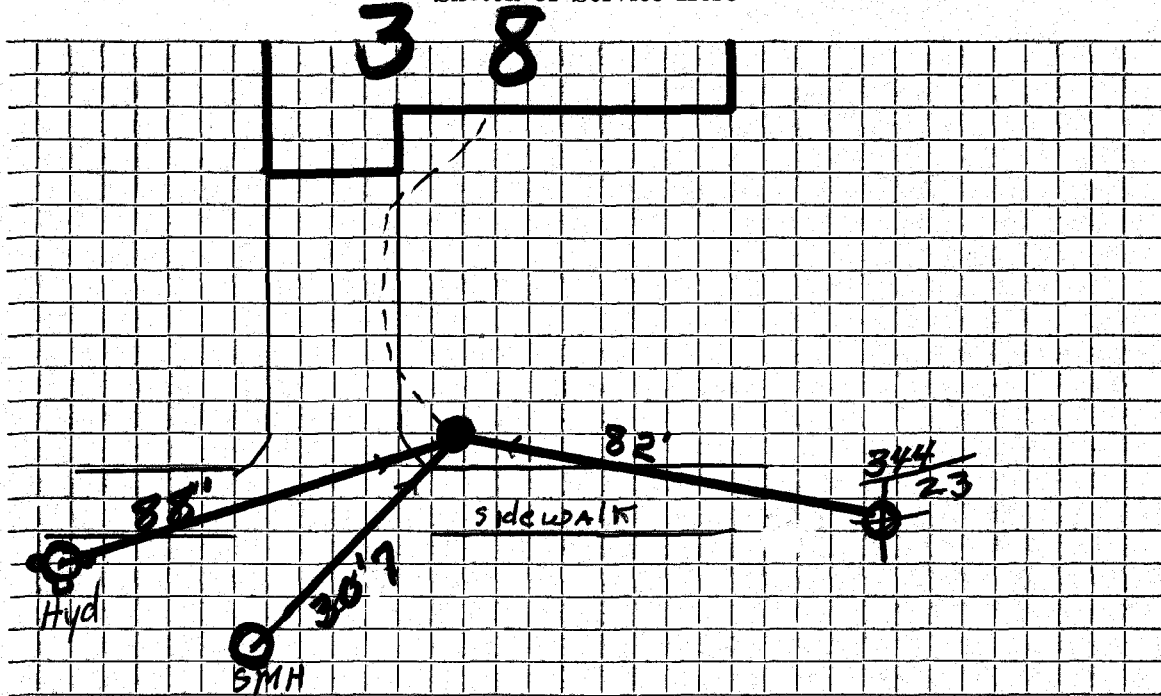

Connection made in Street. Work completed

Remarks:
.....
.....