


DATE _____

TOWN OF LEXINGTON — BOARD OF PUBLIC WORKS

WATER DIVISION

Sketch of Service Here

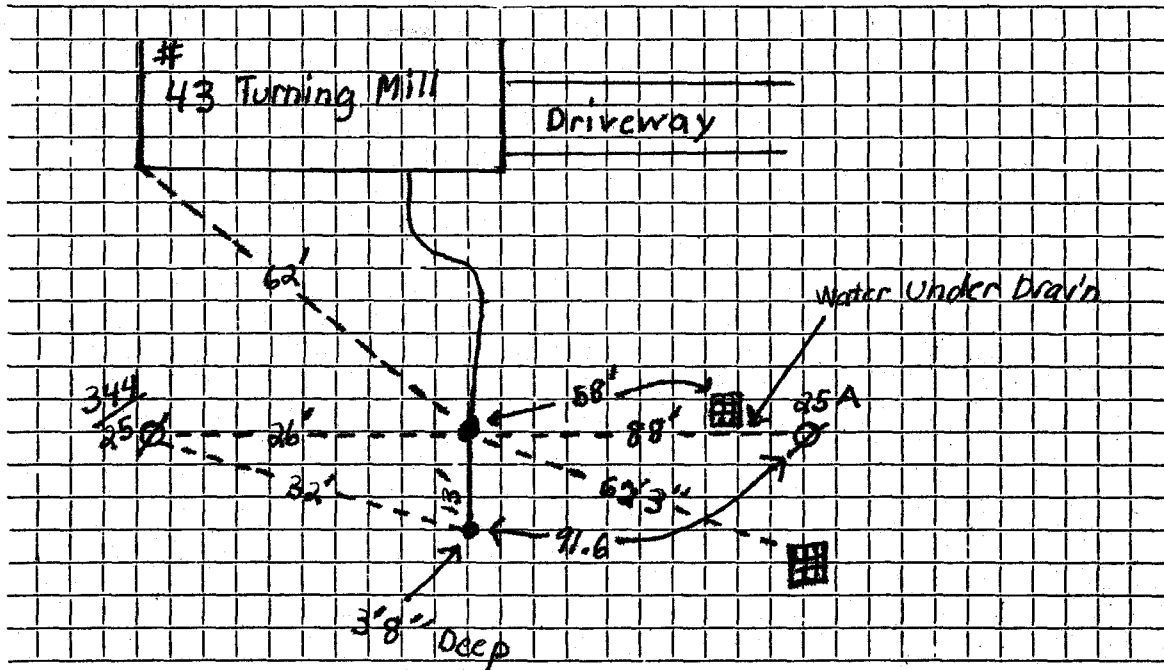

Connection made in Turning Mill Street. Work completed 9-22-00

Remarks: Installed by North Shore Cons.
8" Main