

WATER SERVICE RECORD

Name Sterling Builders

Service No. 251

Address

Lot ^{#45} 22 Turning Mill Road

(House # 25)

Location

3201

~~Repair - Renewal~~ - New Service

Comm 12-2-57


Date	Material	Amount	Total	Date	Amount
10/29/57	labor	10 29		10-28-57 Deposit	90 00
	10% overhead	1 03		1-14-58 Paid	8 84
			11 32		# 98 84
	200' 3/4" copper tubing @.375		75 00		<u>NON CHARGE</u>
	1 3/4" Cx 1/2 IWH stop & waste		4 96	6/15/57 Labor	8 63
	3 3/4" C3 part Union @2.27		6 81		
	1 hr. trucking @.75		75	30' 3/4" Copper tubing @.4228	12 68
			98 84	1 3/4" C Corp Cock	4 64
				1 3/4" C Curb Cock	5 94
				1 Box & Rod	4 62
				1 Hr. trucking @.75	75
					<u>37 26</u>
				1 1/2 straight tail pc.	50
				1 1/2 offset tail pc.	50
					<u>38 26</u>
				# Bill sent 12-13-57	
				\$ 8.84	

DATE _____

TOWN OF LEXINGTON — BOARD OF PUBLIC WORKS

WATER DIVISION

Sketch of Service Here

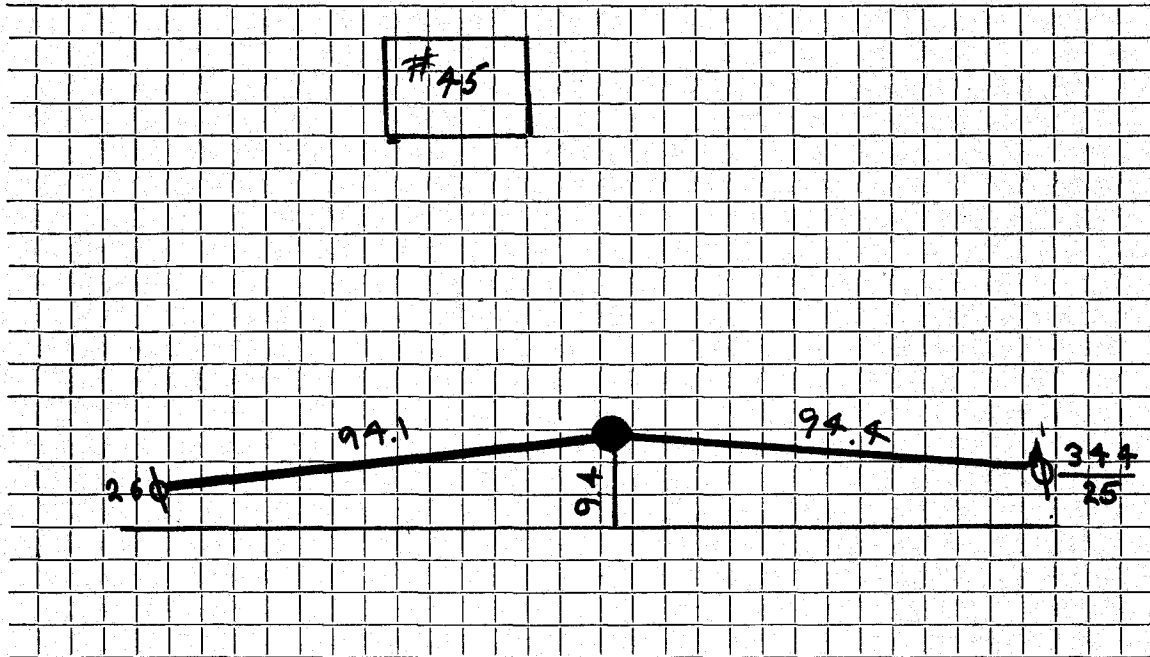

Connection made in Street. Work completed

Remarks:

.....

.....