

WATER SERVICE RECORD

#4197

Name

Service No.

169

Address

House #47
Lot 21 Turning Mill Road

Location

~~Repair - Renewal~~ - New Service

Section 2


Comm 11-9-57

Date	Material	Amount	Total	Date	Amount
7-28-59	Labor	11 25		7-29-59	Deposit 100 00
	10% O. H.	1 13	12 38	11-9-59	Retard 6 28
11-5	3/4" Copper tubing @.41		59 45		93 72
1	3/4" C x 1/2 I.W.H. Stop & Waste	5 84			<u>NON CHARGE</u>
6	3/4" C 3 part Unions @2.30	13 80	6/18/57	Labor	1 91
3	Hrs. Trucking @.75	2 25	30'3/4" Copper tubing @.4228		12 68
		93 72	1 3/4" C Corp Cock		4 64
			1 3/4" C Curb Cock		5 94
			1 Box & Rod		4 62
			1 Hr. trucking @.75		<u>75</u>
					30 54

Applied to WCH #135

TOWN OF LEXINGTON — BOARD OF PUBLIC WORKS

WATER DIVISION

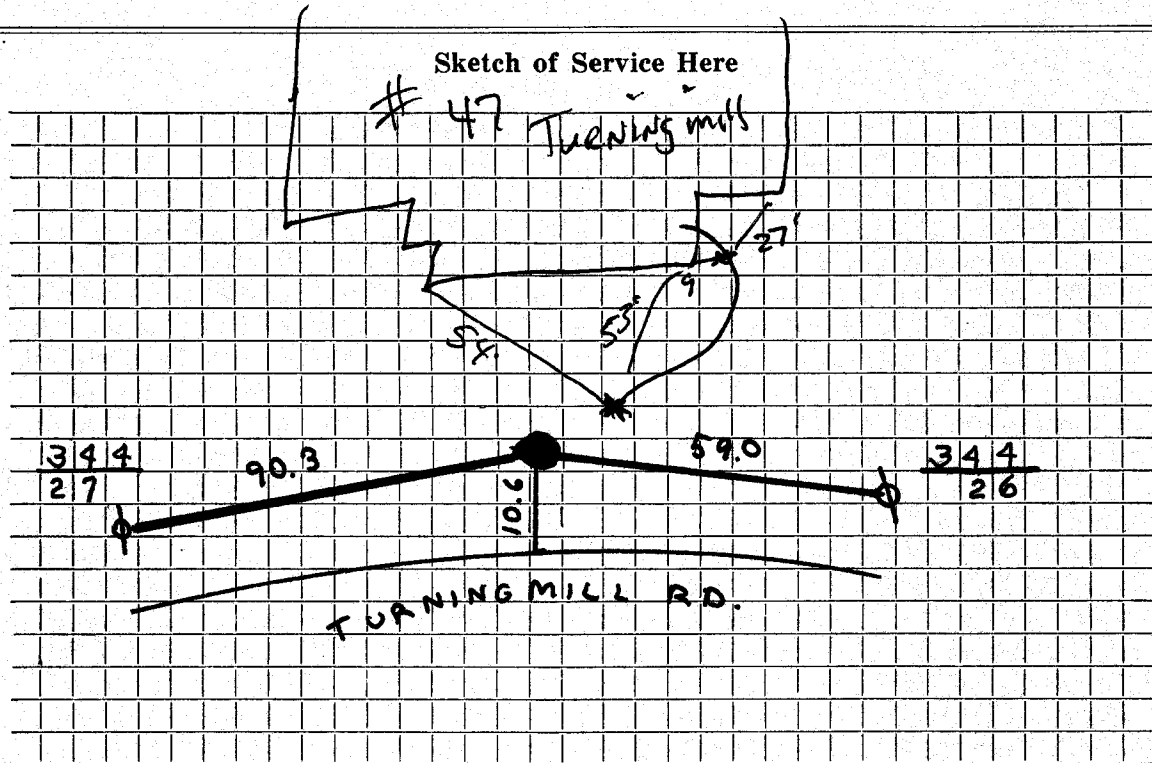

Connection made in ... 5.1.03 ... Street. Work completed

Remarks: ... Repair made in service

2 3/4" 3pt unions