

WATER SERVICE RECORD

Name Benjamin Franklin Homes

Service No. 134

Address House #49 - 15
Lot 20 Turning Mill Road

Location

~~Repair - Renewal~~ New Service Section 2


Comm 10-19-59

Date	Material	Amount	Total	Date	Amount
6-29-59	Labor	3.91		6-17-59	Deposit 50.00
	10% O.H.	.39	4.30	10-26-59	Paid 43.86
	200' 3/4" Copper tubing @.3764		75.28		93.86
	3 3/4" C 3 part union @2.30	6.90			<u>NON CHARGE</u>
	1 3/4" C x 1/2 I.W.H. Stop & Waste	5.88		6/18/57	Labor 1.91
	2 hrs. Trucking @.75	1.50			20' 3/4" Copper tubing @.4228 8.46
			93.86		1 3/4" C Corp Cock 4.64
					1 3/4" C Curb Cock 5.94
					1 Box & Rod 4.62
					1 Hr. trucking @.75 75
					<u>26.32</u>
					1 1/2 Straight tailpiece .50
					1 1/2 Offset tailpiece .50
				9-25-'61	Repair - Broken by Cont. 27.32
					6' 3/4" Copper
					1 3/4" C. Curb Cock
					1 3/4" C. 3 Part Union
					1 3/4" Style 88 Coupling

TOWN OF LEXINGTON — BOARD OF PUBLIC WORKS

WATER DIVISION

Sketch of Service Here

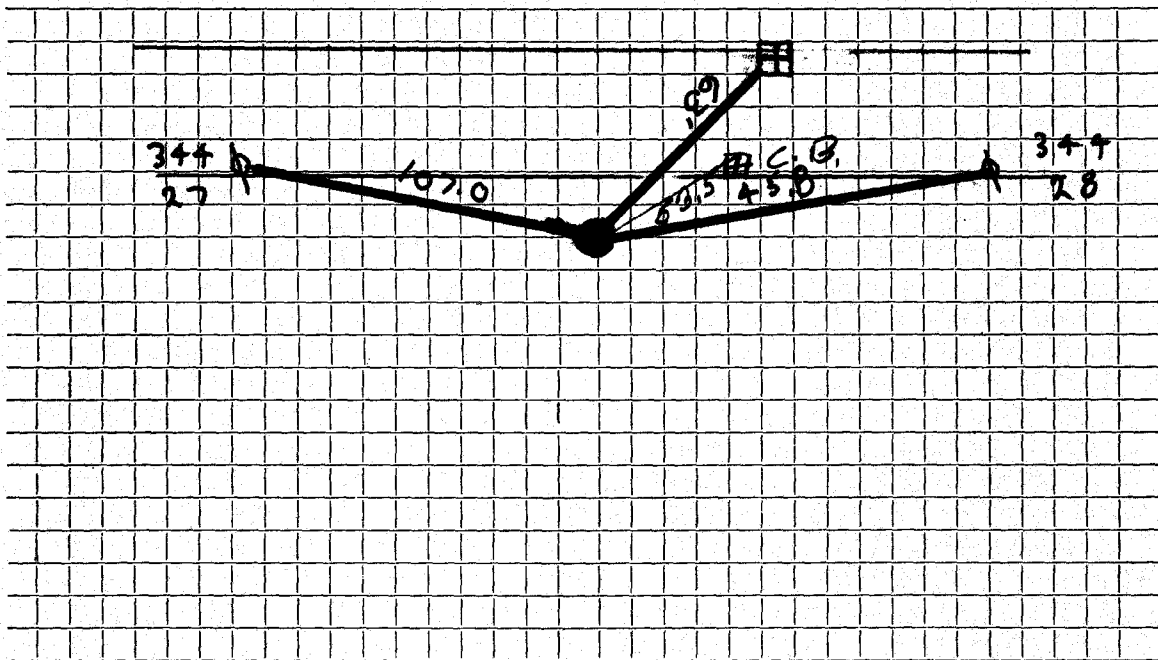

Connection made in Street. Work completed

Remarks:

.....

.....