

WATER SERVICE RECORD

Name DeVries Construction Company

Service No. 41

Address 16 Tyler Road

4118

Location

4119

Repair—Renewal—New Service

Comm 9-24-56

Date	Material	Amount	Total	Date	Amount
4/3/56	Labor	1 95		3-28-56	Deposit <del>*</del> 50 00
	10% overhead	20	2 15	9-24-56	Refund <del>*</del> 2 52
	77' 3/4" copper tubing @ .4850		37.35		<u>NON CHARGES</u> 47 48
	1 3/4" C 2 part Union		2 27		Labor 1 95
	1 3/4" C x 1/2" I.W.H. stop&waste		4 96	8' 3/4" copper tubing @ .4850	3 88
	1 hr. trucking @ .75		75	1 3/4" C Corp Cock	4 34
			47 48	1 3/4" C Curb Cock	5 94
				1 Box & Rod	4 62
				1 1/2 Straight tail piece	50
				1 1/2 Offset tail piece	<u>50</u>
					21 73


\* \$2.52 applied to w.H.C #266

DATE \_\_\_\_\_

# TOWN OF LEXINGTON — BOARD OF PUBLIC WORKS

## WATER DIVISION

Sketch of Service Here

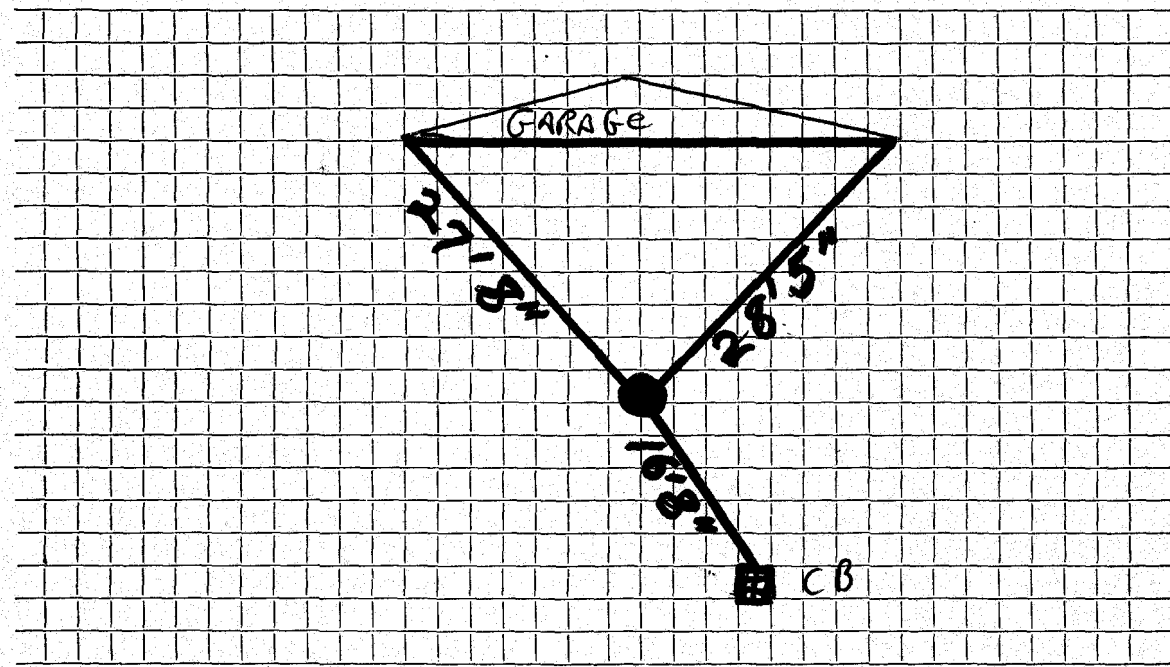

Connection made in ..... Street. Work completed .....

Remarks: .....  
.....  
.....