

## WATER SERVICE RECORD

# 4199

Service No. 42 #6079

#6425

Name DeVries Construction Company

Address 17 Tyler Road

Location


Repair—Renewal—New Service

Comm 9-24-56

Date	Material	Amount	Total	Date	Amount
4/3/56	Labor	1 95		3-28-56	Deposit \$ 50 00
	10% overhead	20	2 15	9-24-56	Refund 18 86
	48' 3/4" copper tubing @ .4850		23 28		<u>NON CHARGES</u> 31 14
	1 3/4" C x 1/8" I.W.H. stop&waste		1 96	20' 3/4" copper tubing @ .4850	9 70
	1 hr. trucking @ .75		75	Labor	1 95
			31 14	1 3/4" C Corp Cock	4 34
				1 3/4" C Curb Cock	5 94
				1 Box & Rod	4 62
				1 1/2 Straight Tail Piece	50
				1 1/2 Offset Tail Piece	50
					27 55
				★ \$18.86 applied to W.H.C. #270	

TOWN OF LEXINGTON — BOARD OF PUBLIC WORKS  
WATER DIVISION

Sketch of Service Here

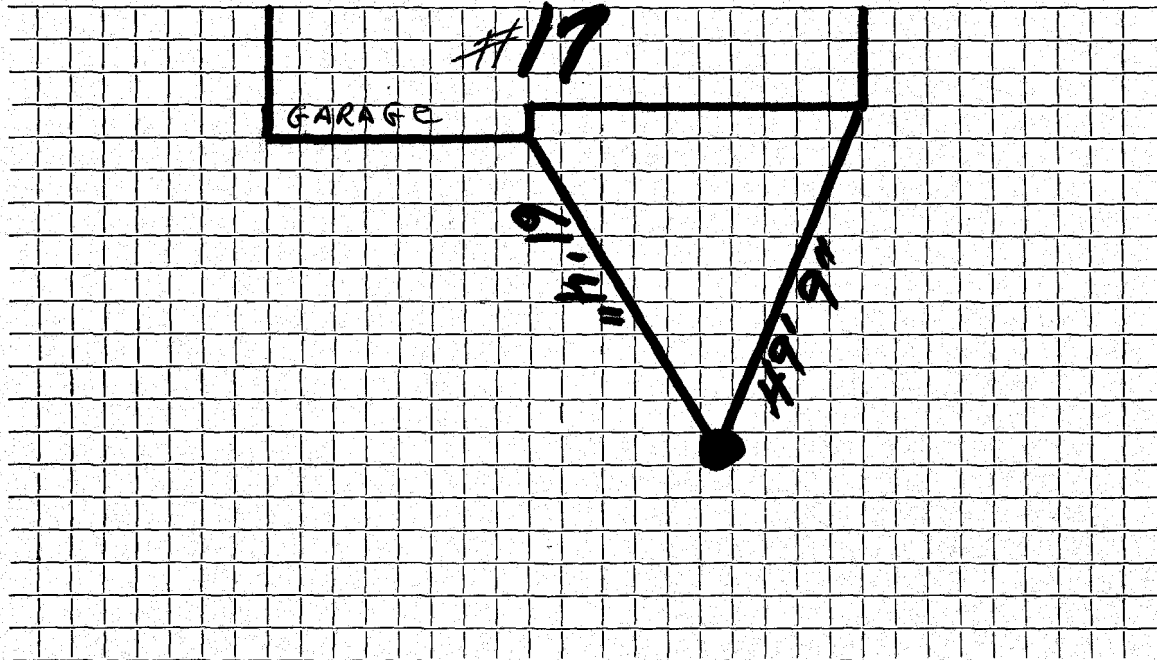

Connection made in ..... Street. Work completed .....

Remarks: .....  
.....  
.....