

WATER SERVICE RECORD

6758

Name DeVries Construction Company

Service No. 43

Address 19 Tyler Road

Location

Repair—Renewal—New Service


Comm - 9-24-56

Date	Material	Amount	Total	Date	Amount
4/3/56	Labor	1 95		3-28-56	Deposit \$ 50 00
	10% overhead	20	2 15	9-24-56	Refund 1 07
	80' 3/4" copper tubing @ .4850		38 80		<u>NON CHARGES</u> 18 93
	1 3/4" C x 1/2" I.W.H. stop&waste		4 96	20' 3/4" copper tubing @ .4850	9 70
	1 hr. trucking @ .75		75	Labor	1 95
	1 3/4" C 3 part Union		2 27	1 3/4" C Corp Cock	4 34
			48 93	1 3/4" C Curb Cock	5 94
				1 Box & Rod	4 62
				1 1/2 Straight tail piece	50
				1 1/2 Offset tail piece	50
					<u>27 55</u>

DATE _____

TOWN OF LEXINGTON — BOARD OF PUBLIC WORKS
WATER DIVISION

Sketch of Service Here

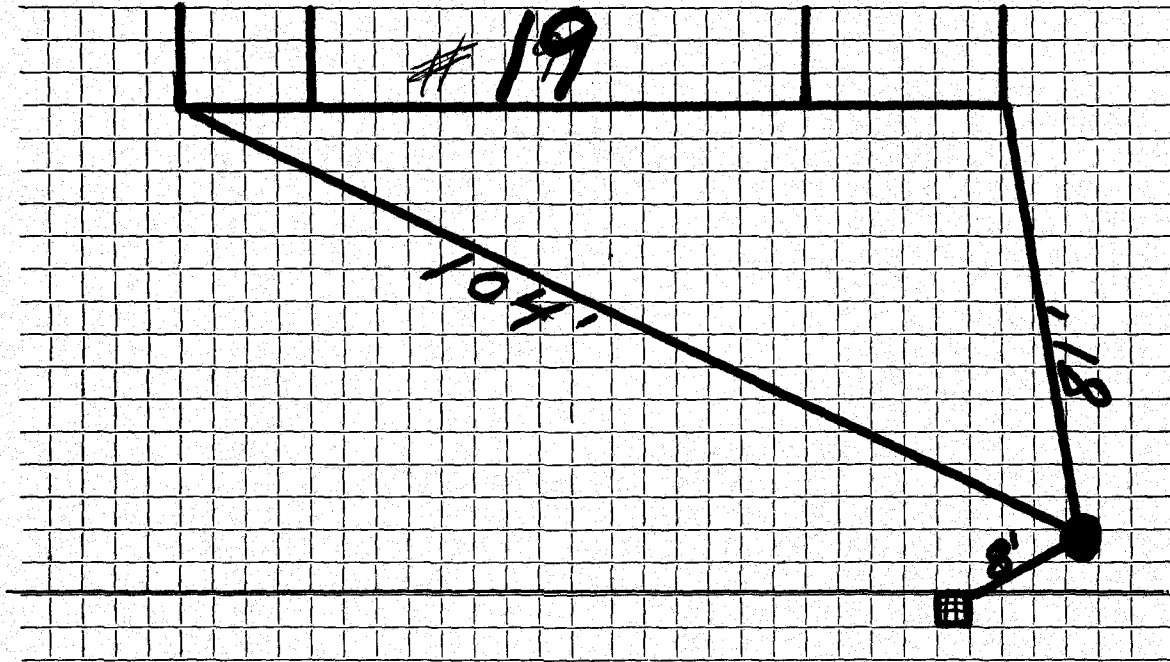

Connection made in Street. Work completed

Remarks:
.....
.....