


DATE 4/24/19

TOWN OF LEXINGTON — BOARD OF PUBLIC WORKS

WATER DIVISION

Sketch of Service Here

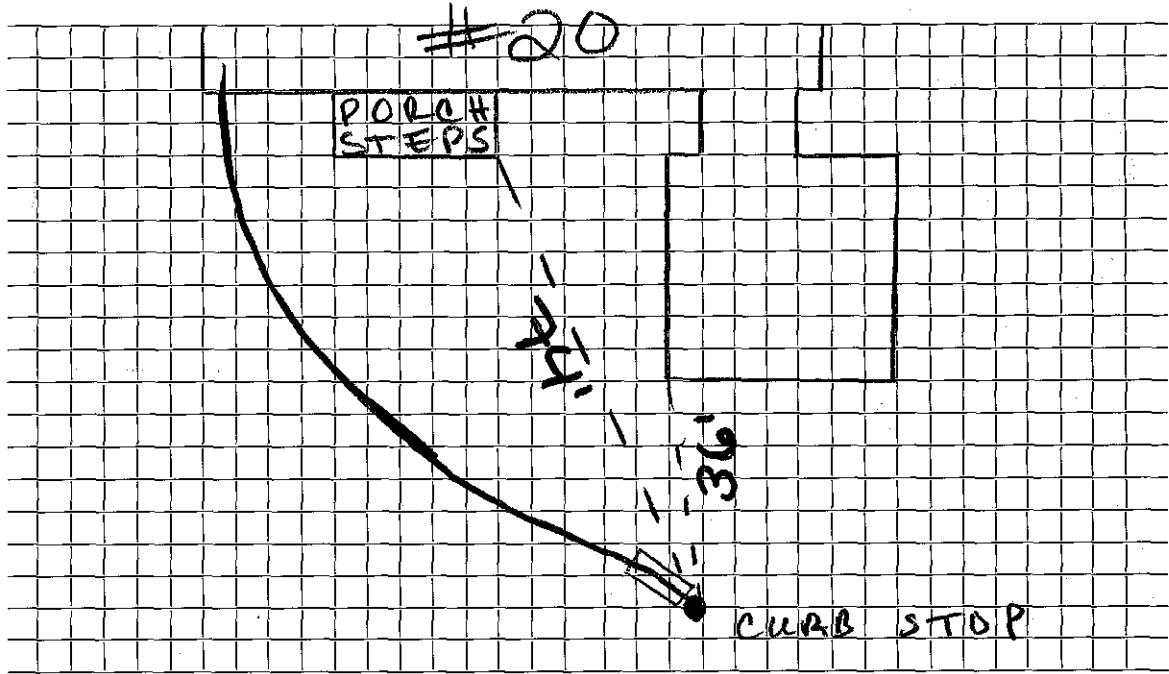

Connection made in Tyler Rd Street. Work completed

Remarks:

Water service @ curb stop runs above sewer service crossing near sewer services Fernco. Encased in PVC where water crosses over sewer → □