
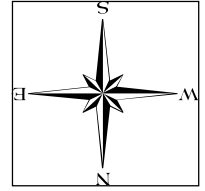


Water Service Tie Card
TOWN OF LEXINGTON
 MASSACHUSETTS

21 Tyler Road

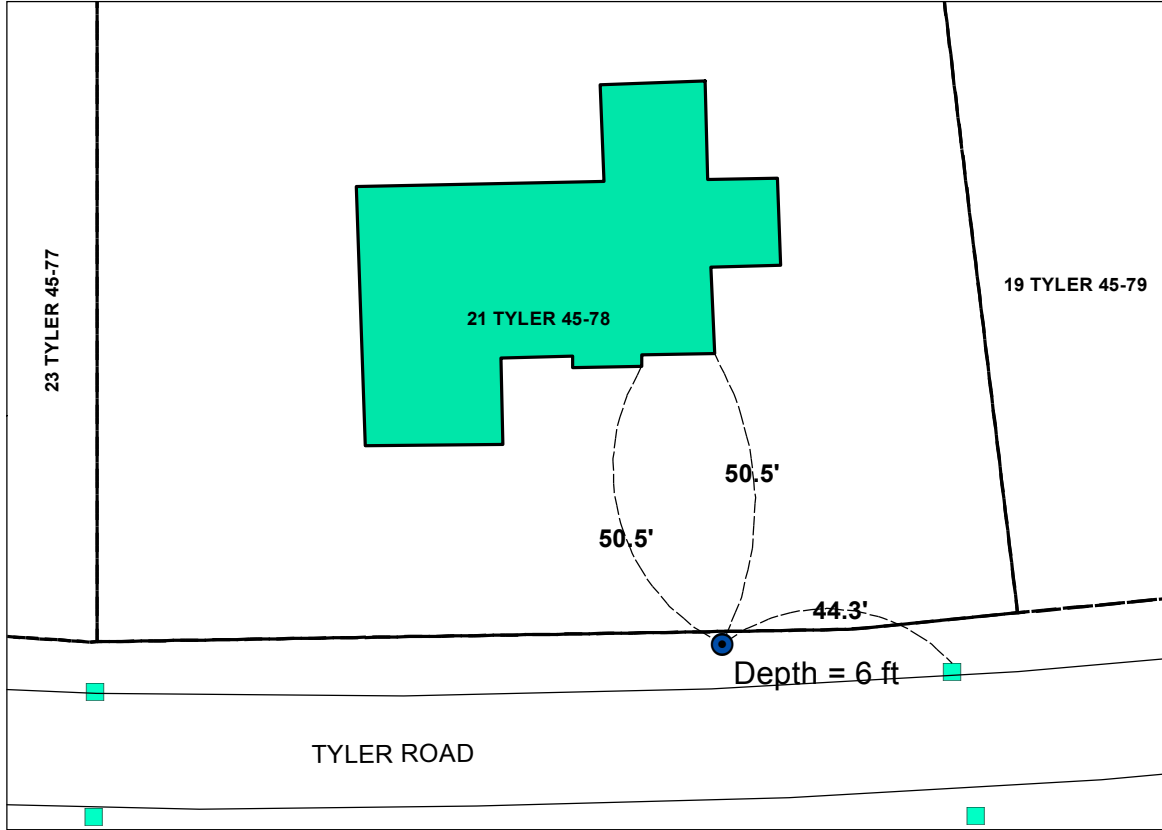

Legend	
●	Curb Stop
---	Ties_Dimensions
—	Water Service Line
---	Property Line
---	Edge of Pavement
	CATCH BASIN

Address	Map and Lot	Permit Number	Contractor Name	Inspector
21 Tyler Road	45-78	5541	Finnegan Development	D. Pavlik

Date: 3/28/14	Material	Amount
	3/4" to 1" fitting	1
	1" Copper type "k"	2 Feet
	1" Curb Valve and Buffalo Box	1
	1" Copper type "k"	65 Feet

Type of work completed
 New 1" water service to house from curb stop. New house on lot old house removed.