

WATER SERVICE RECORD

Name DeVries Construction Company

Service No. 52

Address 28 Tylef Road

Location


Repair—Renewal—New Service

Comm 9-24-56

Date	Material	Amount	Total	Date	Amount
4/3/56	Labor	1 95		3-28-56	Deposit # 50 00
	10% overhead	20	2 15	9-24-56	Refund (14 49
	57' 3/4" copper tubing @ .4850		27 65		<u>NON CHARGES</u> 35 51
	1 3/4" C X 1/2" I.W.H. stop&waste		4 96	Labor	1 95
	1 hr. trucking @ .75		75	7' 3/4" copper tubing @ .4850	3 40
			35 51	1 3/4" C Corp Cock	4 34
				1 3/4" C Curb Cock	5 94
				1 Box & Rod	4 62
				1 1/2 Straight Tail Piece	50
				1 1/2 Offset Tail Piece	50
					21 25

TOWN OF LEXINGTON — BOARD OF PUBLIC WORKS
WATER DIVISION

Sketch of Service Here

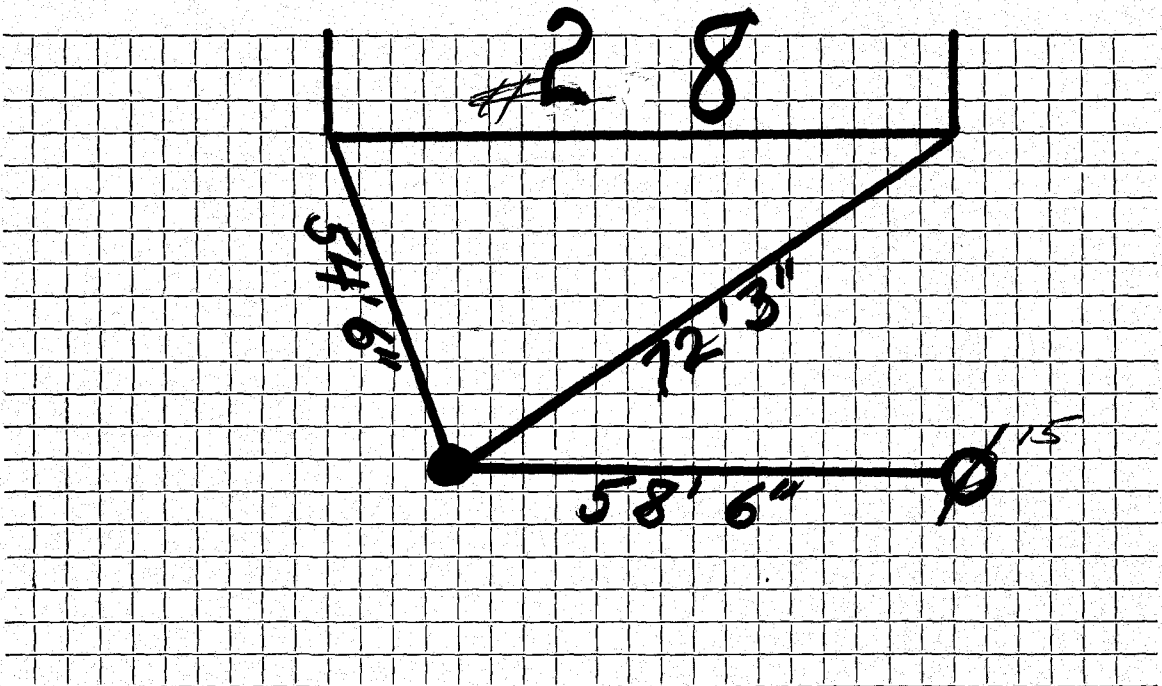

Connection made in Street. Work completed

Remarks:
.....
.....