

WATER SERVICE RECORD

Service No.

#971
#3790
53

Name DeVries Construction Company

Address 29 Tyler Road

Location

Repair—Renewal—New Service


Comm 9-24-56

Date	Material	Amount	Total	Date	Amount
4/3/56	Labor	1 95		3-28-56	Deposit \$ 50 00
	10% overhead	20	2 15	9-24-56	Refund \$ 8 34
	65' 3/4" copper tubing @ .4850		31 53		<u>NON CHARGES</u> 41 66
	1 3/4" C 3 part Union		2 27	Labor	1 95
	1 3/4" C x 1/2" I.W.H. stop&waste		4 96	21' 3/4" copper tubing @ .4850	10 19
	1 hr. trucking @ .75		75	1 3/4" C Corp Cock	4 34
			41 66	1 3/4" C Curb Cock	5 94
				1 Box & Rod	4 62
				1 1/2 Straight Tail Piece	50
				1 1/2 Offset Tail Piece	50
					28 04

* \$ 1.74 applied to W.H.C #40

TOWN OF LEXINGTON — BOARD OF PUBLIC WORKS
WATER DIVISION

Sketch of Service Here

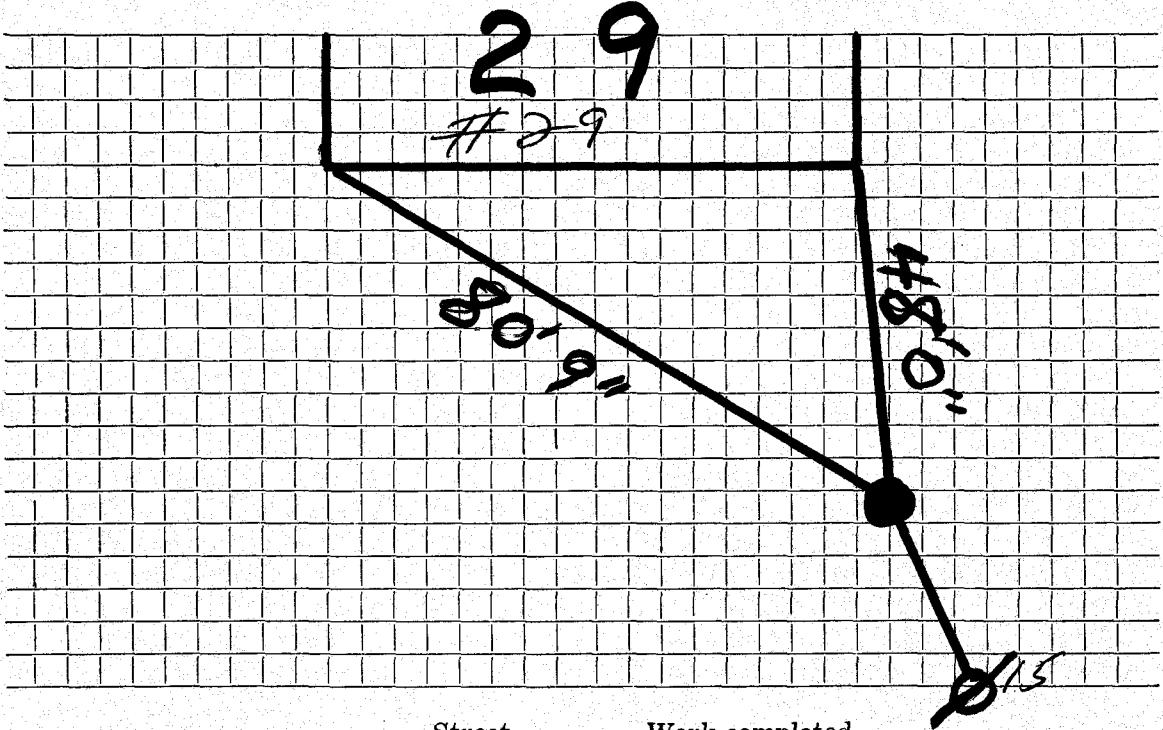

Connection made in Street. Work completed

Remarks:
.....
.....