

## WATER SERVICE RECORD

Name DeVries Construction Company

Service No. 54

Address 30 Tyler Road

# 3180 + 3181

Location

Repair—Renewal—New Service


Comm - 9 - 24 - 56

Date	Material	Amount	Total	Date	Amount
4/3/56	Labor	1 95		3-28-56	Deposit \$ 50 00
	10% overhead	20	2 15	9-24-56	Refund 19 34
	47' 3/4" copper tubing @ .4850		22 80		NON CHARGES 30 66
	1 3/4" C x 1/2" I.W.H. stop&waste		4 96		Labor 1 95
	1 hr. trucking @ .75		75		8' 3/4" copper tubing @ .4850 3 88
			30 66		1 3/4" C Corp Cock 4 34
					1 3/4" C Curb Cock 5 94
					1 Box & Rod 4 62
					1 1/2 Straight tail piece 50
					1 1/2 Offset tail piece 50
					21 73

TOWN OF LEXINGTON — BOARD OF PUBLIC WORKS

WATER DIVISION

Sketch of Service Here

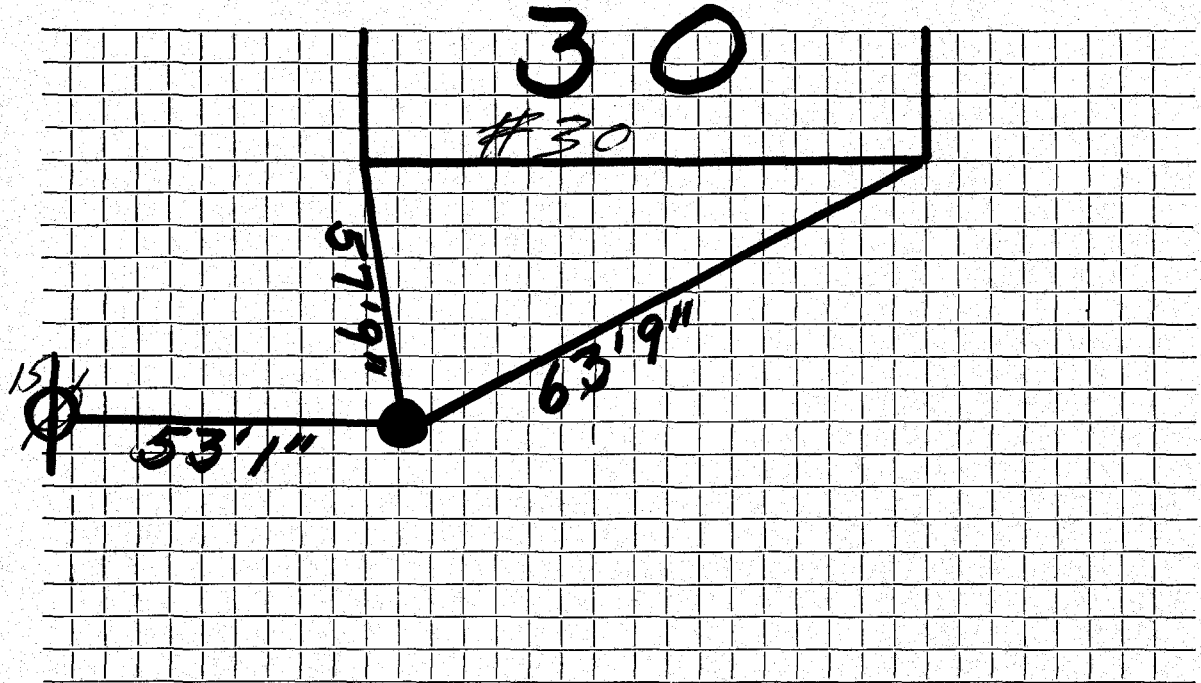

Connection made in ..... Street. Work completed .....

Remarks: .....  
.....  
.....