

WATER SERVICE RECORD

Name DeVries Construction Company

Service No. 59

Address 31 Tyler Road

Location

Repair—Renewal—New Service

Comm. 9-24-56


| Date | Material | Amount | Total | Date | Amount |
|--------|-----------------------------------|--------|-------|---------------------------------------|--------|
| 4/3/56 | Labor | 1 95 | | 4-6-56 Deposit | 50 00 |
| | 10% overhead | 20 | 2 15 | 9-24-56 Refund Δ | 19 34 |
| | 47' 3/4" copper tubing @ .4850 | | 22 80 | <u>NON CHARGES</u> | 30 66 |
| | 1 3/4" C x 1/2" I.W.H. stop&waste | | 4 96 | Labor | 1 95 |
| | 1 hr. trucking @ .75 | | 75 | 20' 3/4" copper tubing @ .4850 | 9 70 |
| | | | 30 66 | 1 3/4" C Corp Cock | 4 34 |
| | | | | 1 3/4" C Curb Cock | 5 94 |
| | | | | 1 Box & Rod | 4 62 |
| | | | | 1 1/2 Straight Tail Piece | 50 |
| | | | | 1 1/2 Offset Tail Piece | 50 |
| | | | | | 27 55 |
| | | | | Δ #18.44 applied To W.H.C# 273 | |

DATE _____

TOWN OF LEXINGTON — BOARD OF PUBLIC WORKS

WATER DIVISION

Sketch of Service Here

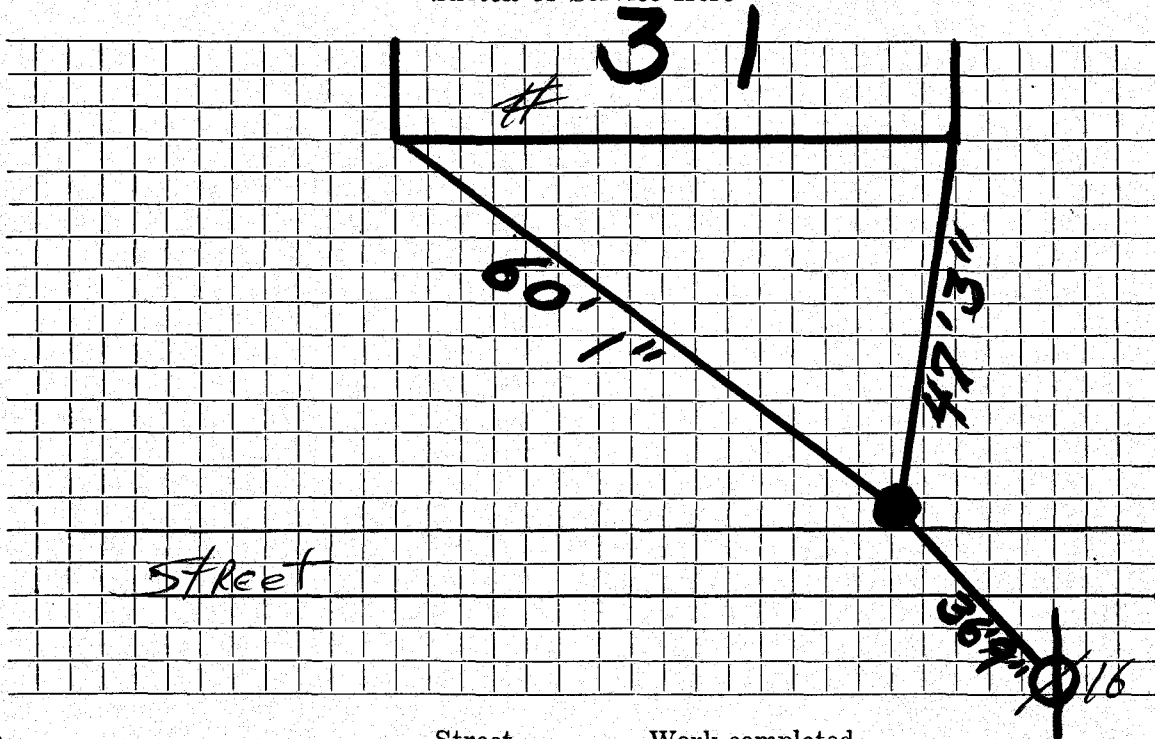

Connection made in Street. Work completed

Remarks:

.....

.....