


DATE Aug. 2018

TOWN OF LEXINGTON — BOARD OF PUBLIC WORKS
WATER DIVISION

Sketch of Service Here

#32

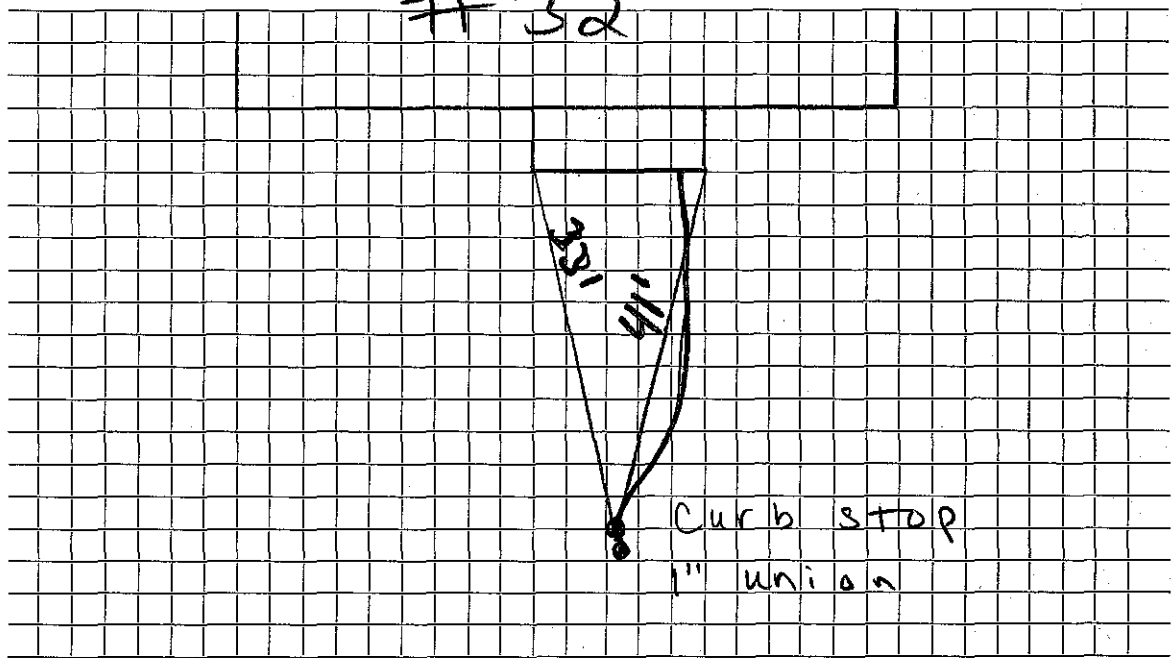

Connection made in Tyler Rd Street. Work completed

Remarks: