

WATER SERVICE RECORD

Name DeVries Construction Company

Service No. 61

Address 34 Tyler Road

Location

Repair—Renewal—New Service


Comm 9-24-56

Date	Material	Amount	Total	Date	Amount
4/7/56	Labor	1 95		4-6-56 Deposit	50 00
	10% overhead	20	2 15	9-24-56 Refund *	25 16
	35' 3/4" copper tubing @ .4850		16 98	<u>NON CHARGES</u>	24 84
	1 3/4" C x 1/2" I.W.H. stop&waste		4 96	Labor	1 95
	1 hr. trucking @ .75		75	8' 3/4" copper tubing @ .4850	3 88
			24 84	1 3/4" C Corp Cock	4 34
				1 3/4" C Curb Cock	5 94
				1 Box & Rod	4 62
				1 1/2 Straight Tail Piece	50
				1 1/2 Offset Tail Piece	50
					21 73
				* \$25 16 applied to bal. due on W.I.C. # 274	

DATE _____

TOWN OF LEXINGTON — BOARD OF PUBLIC WORKS
WATER DIVISION

Sketch of Service Here

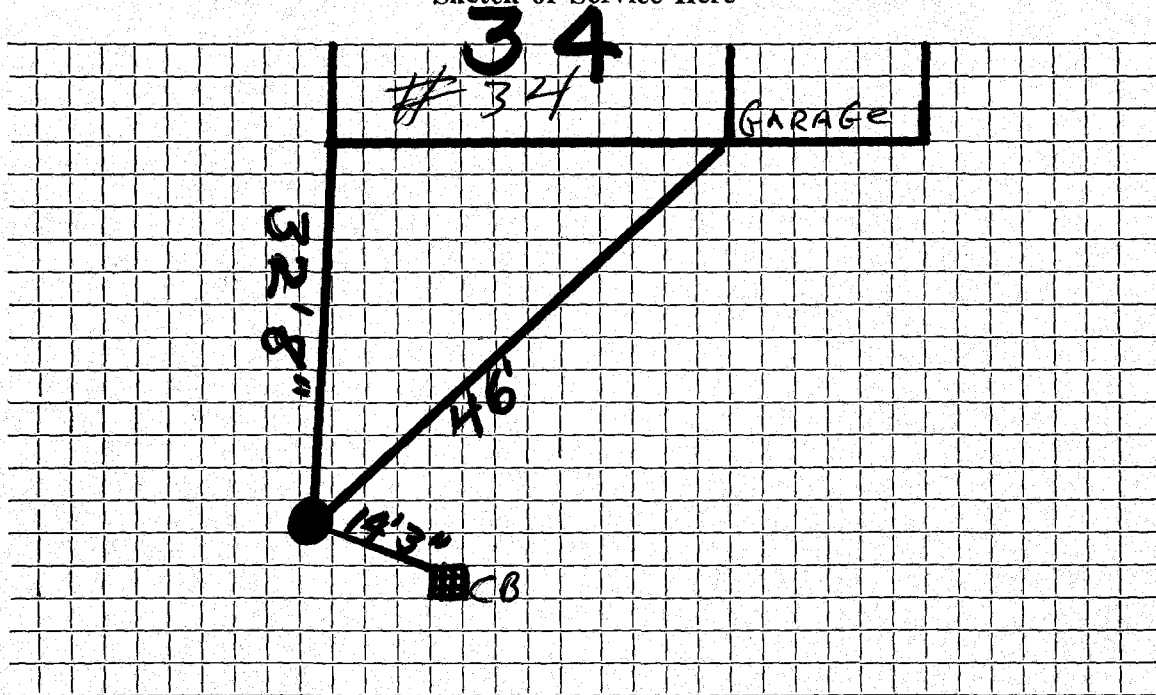

Connection made in Street. Work completed

Remarks:
.....
.....