

WATER SERVICE RECORD

Name DeVries Construction Company

Service No. 62

Address 35 Tyler Road

Location

Repair—Renewal—New Service

Comm 9-24-56


Date	Material	Amount	Total	Date	Amount
4/16/56	Labor	1 95		4-6-56	Deposit \$ 50 00
	10% overhead	20	2 15	9-24-56	Refund (10
	82' 3/4" copper tubing @ .4850		39 77		NON CHARGES 49 90
	1 3/4" C 3 part Union		2 27		Labor 1 95
	1 3/4" C x 1/2" I.W.H. stop&waste		4 96		21' 3/4" copper tubing @ .4850 10 19
	1 hr. trucking @ .75		75		1 3/4" C Corp Cock 4 34
			49.90		1 3/4" C Curb Cock 5 94
					1 Box & Rod 4 62
					1 1/2 Straight Tail Piece 50
					1 1/2 Offset Tail Piece 50
					28 04

DATE _____

TOWN OF LEXINGTON — BOARD OF PUBLIC WORKS

WATER DIVISION

Sketch of Service Here

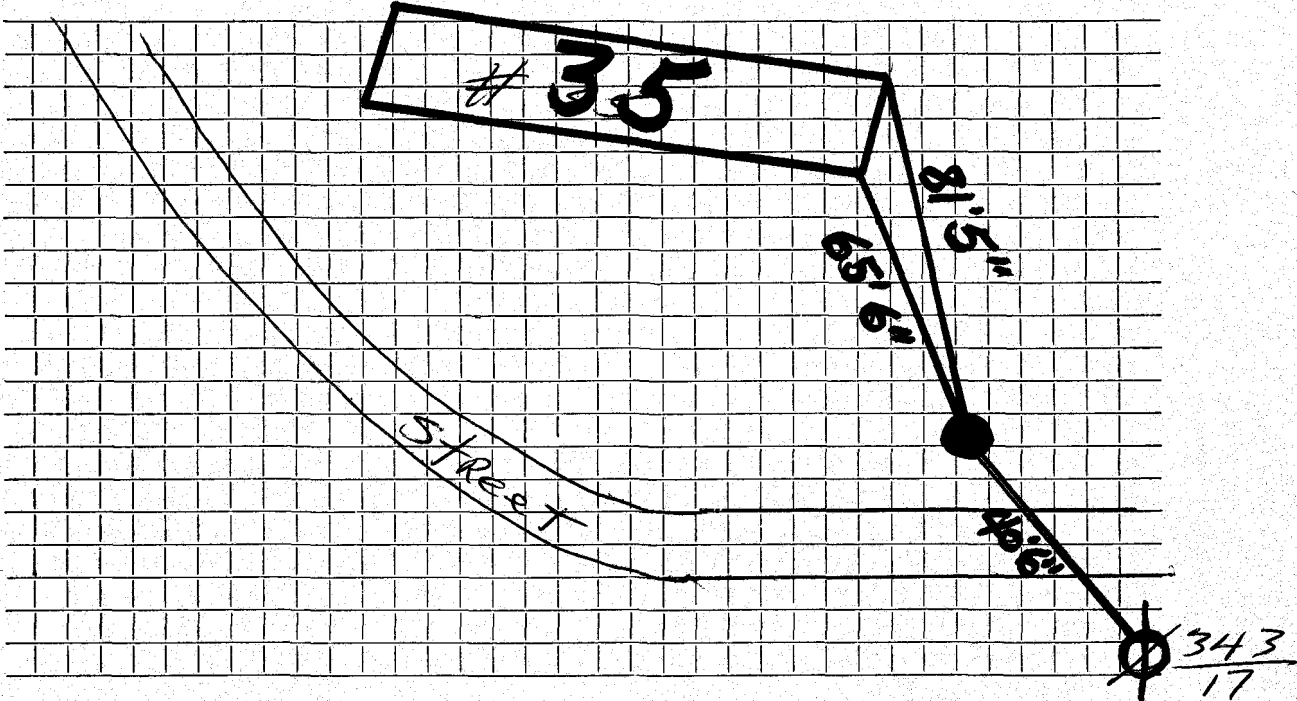

Connection made in Street. Work completed

Remarks:
.....
.....