

WATER SERVICE RECORD

Name DeVries Construction Company

Service No.

63

Address 36 Tyler Road

Location

Repair—Renewal—New Service

Comm 9-24-56

Date	Material	Amount	Total	Date	Amount	
4/10/56	Labor	1 95		4-6-56	Deposit	50 00
	10% overhead	20	2 15	9-24-56	Refund	21 28
	1/3' 3/4" copper tubing @ .4850		20 86		<u>NON CHARGES</u>	28 72
	1 3/4" C x 1/2" I.W.H. stop&waste		4 96		Labor	1 95
	1 hr. trucking @ .75		75		7' 3/4" copper tubing @ .4850	3 40
			28 72		1 3/4" C Corp Cock	4 34
					1 3/4" C Gurb Cock	5 94
					1 Box & Rod	4 62
					1 1/2 Straight Tail Piece	50
					1 1/2 Offset Tail Piece	50
						21 25


* \$21.28 applied to W.H.C. #273

DATE _____

TOWN OF LEXINGTON — BOARD OF PUBLIC WORKS

WATER DIVISION

Sketch of Service Here

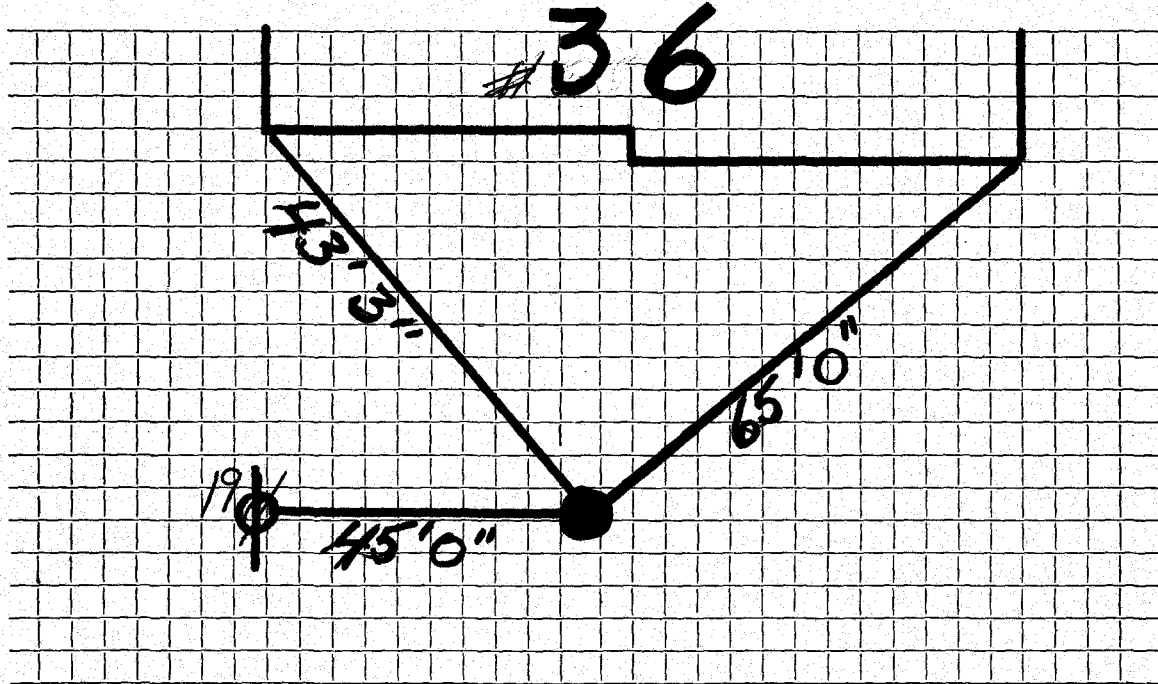

Connection made in Street. Work completed

Remarks:
.....
.....