

WATER SERVICE RECORD

Name DeVries Construction Company

Service No. 274

Address 37 Tyler Road

Location

Repair—Renewal—New Service

Comm - 9-24-56

Date	Material	Amount	Total	Date	Amount
4/16/56	Labor	1 95		9-24-56	25 16
	10% overhead	20	2 15	"	4 53
	45' 3/4" copper tubing @ .4850		21 83		
	1 3/4" C x 1/2" I.W.H. stop & waste		4 96		
	1 hr. trucking @ .75		75		
			29 69		
				21' 3/4" copper tubing @ .4850	10 19
				1 3/4" C Corp Cock	1 34
				1 3/4" C Curb Cock	5 94
				1 Box & Rod	1 62
				1 1/2 Straight Tail Piece	50
				1 1/2 Offset Tail Piece	50
					28 04


Pd. by Ref. on W.N.C.# 61 #48

NON CHARGES

TOWN OF LEXINGTON — BOARD OF PUBLIC WORKS

WATER DIVISION

Sketch of Service Here

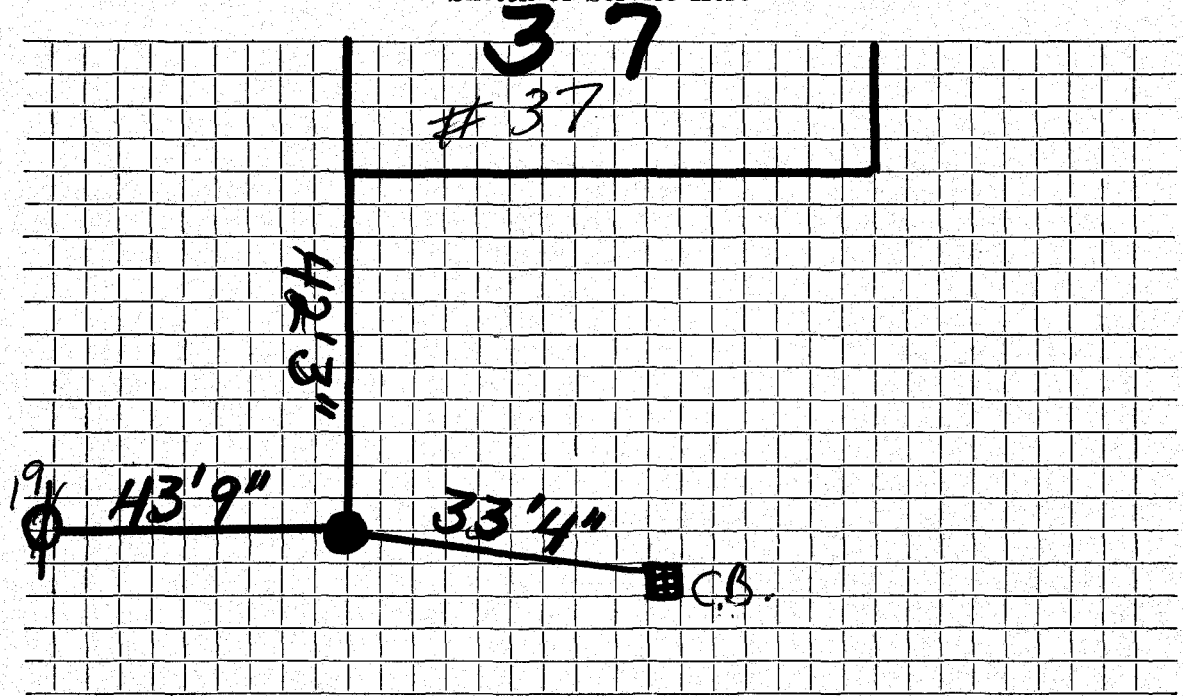

Connection made in Street. Work completed

Remarks:
.....
.....