

WATER SERVICE RECORD

Name DeVries Construction Company

Service No. 64

Address 38 Tyler Road

1899

Location

Repair—Renewal—New Service


Comm - 9-24-56

Date	Material	Amount	Total	Date	Amount
4/10/56	Labor	1 95		4-6-56	Deposit 50 00
	10% overhead	20	2 15	9-24-56	Refund 20 31
	45' 3/4" copper tubing @ .4850		21 83		<u>NON CHARGES</u> 29 69
	1 3/4" C x 1/2" I.W.H. stop&waste		4 96		
	1 hr. trucking @ .75		75		
			29 69		
				6' 3/4" copper tubing @ .4850	2 91
				1 3/4" C Corp Cock	4 34
				1 3/4" C Curb Cock	5 94
				1 Box & Rod	4 62
				1 1/2 Straight tail piece	50
				1 1/2 Offset tail piece	50
					<u>18 81</u>

DATE _____

TOWN OF LEXINGTON — BOARD OF PUBLIC WORKS
WATER DIVISION

Sketch of Service Here

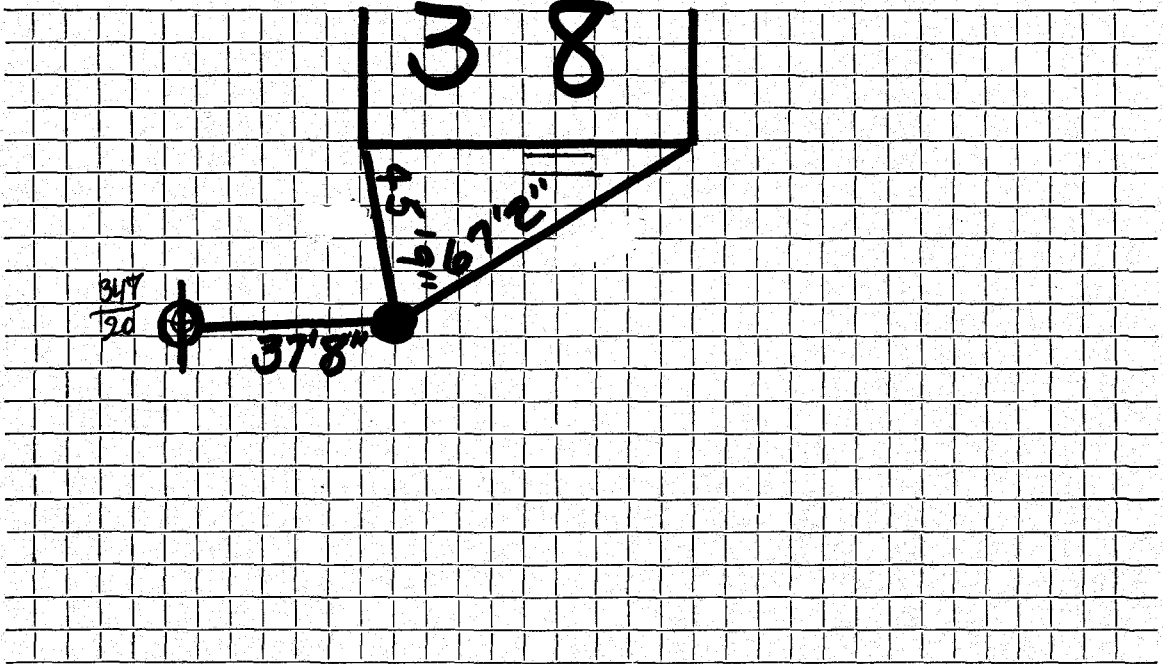

Connection made in Street. Work completed

Remarks:
.....
.....