

WATER SERVICE RECORD

#4943

Name DeVries Construction Company

Service No. 65

Address 40 Tyler Road

Location

Repair—Renewal—New Service


Comm 9-24-56

Date	Material	Amount	Total	Date	Amount
4/16/56	Labor	1 95		4-6-56	Deposit # 50 00
	10% overhead	20	2 15	9-24-56	Refund 5 43
	71' 3/4" copper tubing @ .4850		34 1/4		<u>NON CHARGES</u> 44 67
	1 3/4" C 3 part Union		2 27	Labor	1 95
	1 3/4" C x 1/2" I.W.H. stop&waste		4 96	8' 3/4" copper tubing @ .4850	3 88
	1 hr. trucking @ .75		75	1 3/4" C Corp Cock	4 34
			44 57	1 3/4" C Curb Cock	5 94
				1 Box & Rod	1 62
				1 1/2 Straight Tail Piece	50
				1 1/2 Offset Tail Piece	50
					21 73

DATE _____

TOWN OF LEXINGTON — BOARD OF PUBLIC WORKS
WATER DIVISION

Sketch of Service Here

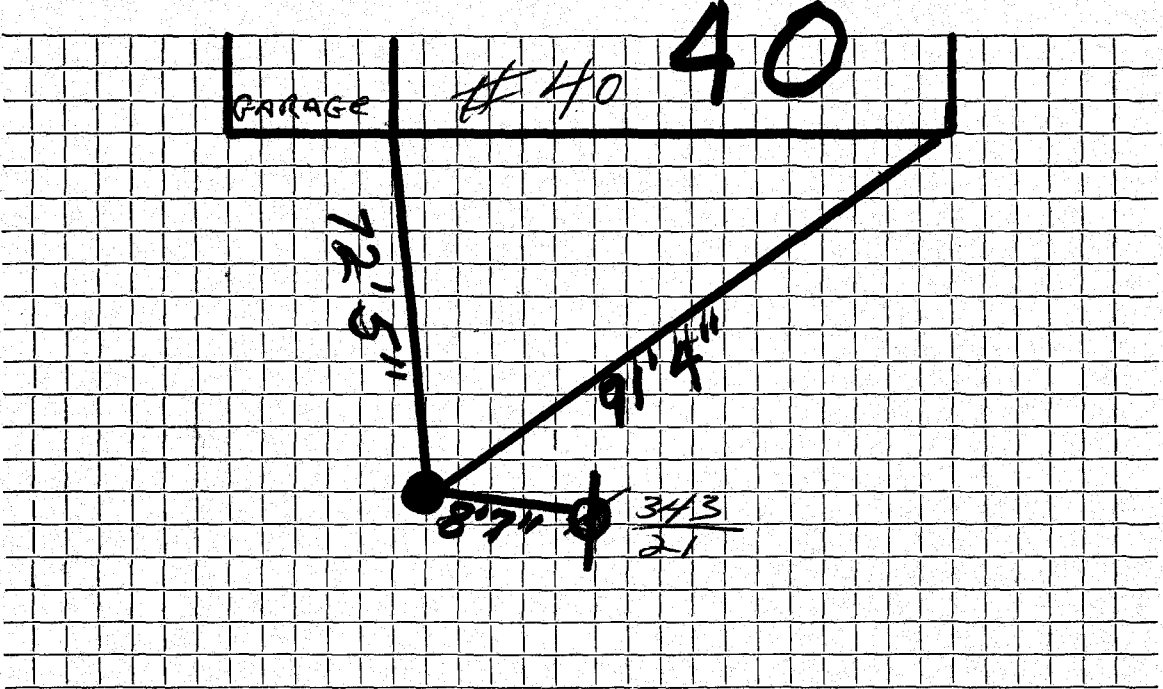

Connection made in Street. Work completed

Remarks:
.....
.....