

WATER SERVICE RECORD

Name DeVries Construction Co., Inc.

Service No. 433 N. D.

Address 6 Tyler Road

# 4900

Location

# 4901

Repair: ~~Renewal~~ - New Service

*Com. 12-31-55*

# 4902


Date	Material	Amount	Total	Date	Amount
11/8/55	Labor	1 85		<i>8-30-56 Paid</i>	# 38 15
	10% overhead	19	2 04		
	56' - 3/4" copper tubing @ .56		31 36		NON CHARGE
	1 - 3/4Cx1/2 I.W.H. Stop & Waste		4 00	Labor	1 85
	1 hr. trucking		75	15' - 3/4" copper tubing @ .56	8 40
			38 15	1 - 3/4" C. Corp Cock	4 33
				1 - 3/4" C. Curb cock	4 67
				1 box & rod	3 90
				1 - 1/2" straight tail piece	50
				1 - 1/2" offset tail piece	50
					24 15

*Bill sent 1-10-56*

DATE \_\_\_\_\_

**TOWN OF LEXINGTON — BOARD OF PUBLIC WORKS**  
**WATER DIVISION**

Sketch of Service Here

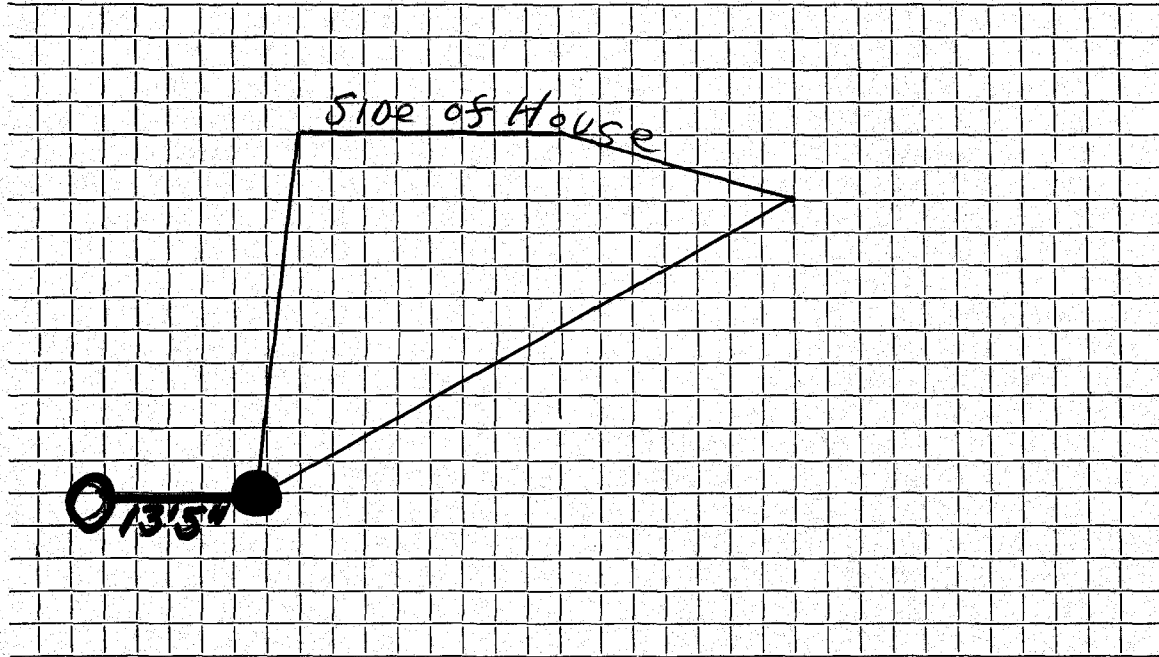

Connection made in ..... Street.      Work completed .....

Remarks: .....  
.....  
.....