

WATER SERVICE RECORD

Name DeVries Construction Co., Inc.

Service No. 434 N.D.

Address 8 Tyler Road

Location
~~Repair & Renewal~~ — **New Service**
Com. 12-31-55


Date	Material	Amount	Total	Date	Amount
11/17/55	Labor	1 85		8-30-56	45 74 03
	10% overhead	19	2 04		
	117' - 3/4" copper tubing @ .56		65 52		NON CHARGE
	1 - 3/4" C. Union (3 parts)		1 72	Labor	1 85
	1 - 3/4" x 1/2" I.W.H. Stop & Waste		4 00	8' - 3/4" copper tubing @ .56	4 48
	1 hr. trucking		75	1 - 3/4" C. Curb cock	4 67
			74 03	1 - 3/4" C. Corp cock	4 33
				1 box & rod	3 90
				1 - 1/2" straight tail piece	50
				1 - 1/2" offset tail piece	50
					<u>20 23</u>

Bill sent 1-10-56

DATE _____

TOWN OF LEXINGTON — BOARD OF PUBLIC WORKS
WATER DIVISION

Sketch of Service Here

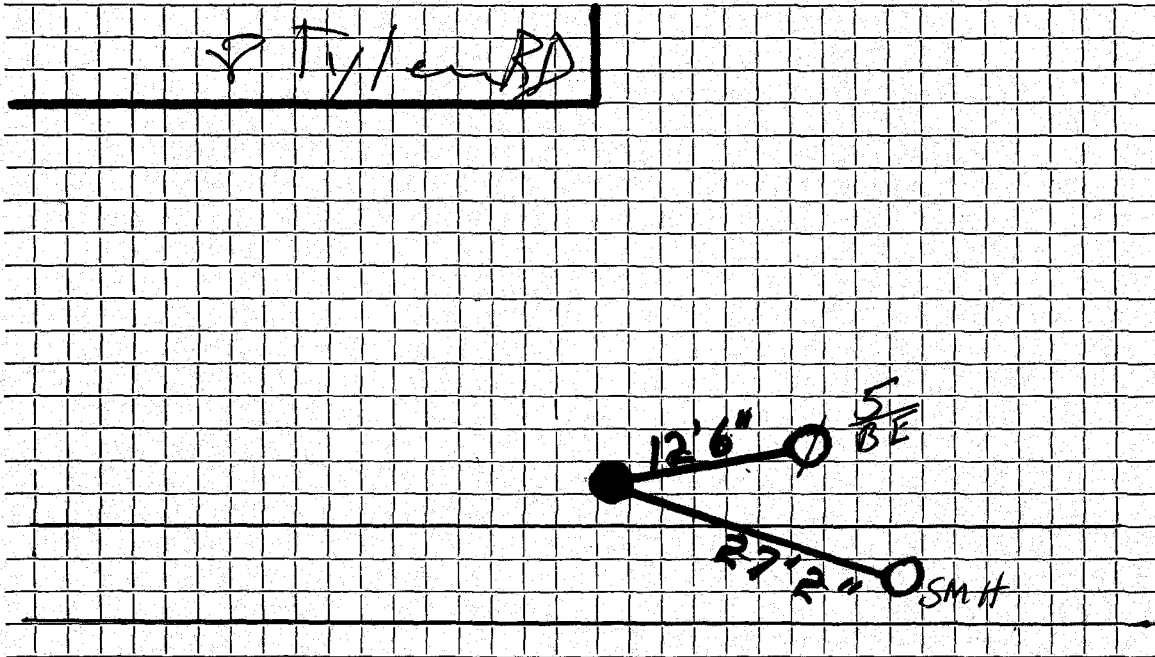

Connection made in Street. Work completed

Remarks:
.....
.....