


Water Service Tie Card
TOWN OF LEXINGTON
 MASSACHUSETTS

37 Normandy Rd

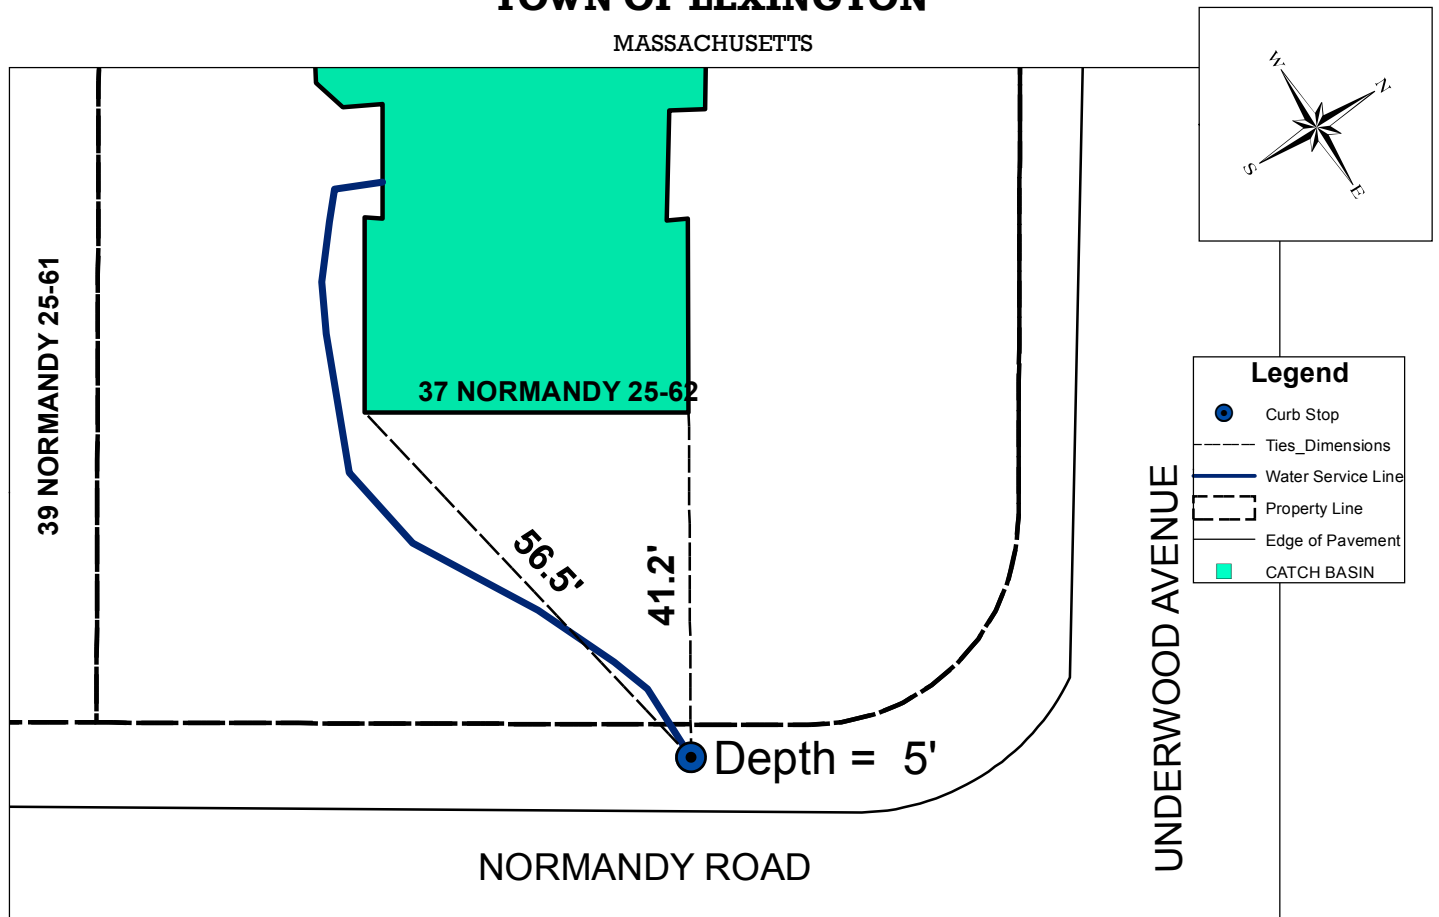

Address	Map and Lot	Permit Number	Contractor Name	Inspector
37 Normandy	25-62	5803	McLaughlin, James M. Inc.	msprague
Date	Material	Depth of Cover	Amount	
9/30/2014	3/4" Copper type "k"	5 ft	1 ft	
	3/4" to 1" fitting	5 ft	1	
	1" Copper type "k"	5 ft	1 ft	
	1" Curb Valve and Buffalo Box	5 ft	1	
	1" Copper type "k"	5 ft	96 ft	
Type of work completed				

New 1" water service to house from curb stop. New house on lot old house removed.