

WATER SERVICE RECORD

Name Megan Shadley

Service No.

Address (unknown)

Contractor (unknown)

Location Lexington MA

Repair—Renewal—New Service


Date	Material	Amount	Total	Date	Amount
1/14/2019	1" curb stop (F)	1			
	Bend around infiltration				
	↳ Unit (G)	1			

DATE _____

TOWN OF LEXINGTON — BOARD OF PUBLIC WORKS

WATER DIVISION

Sketch of Service Here

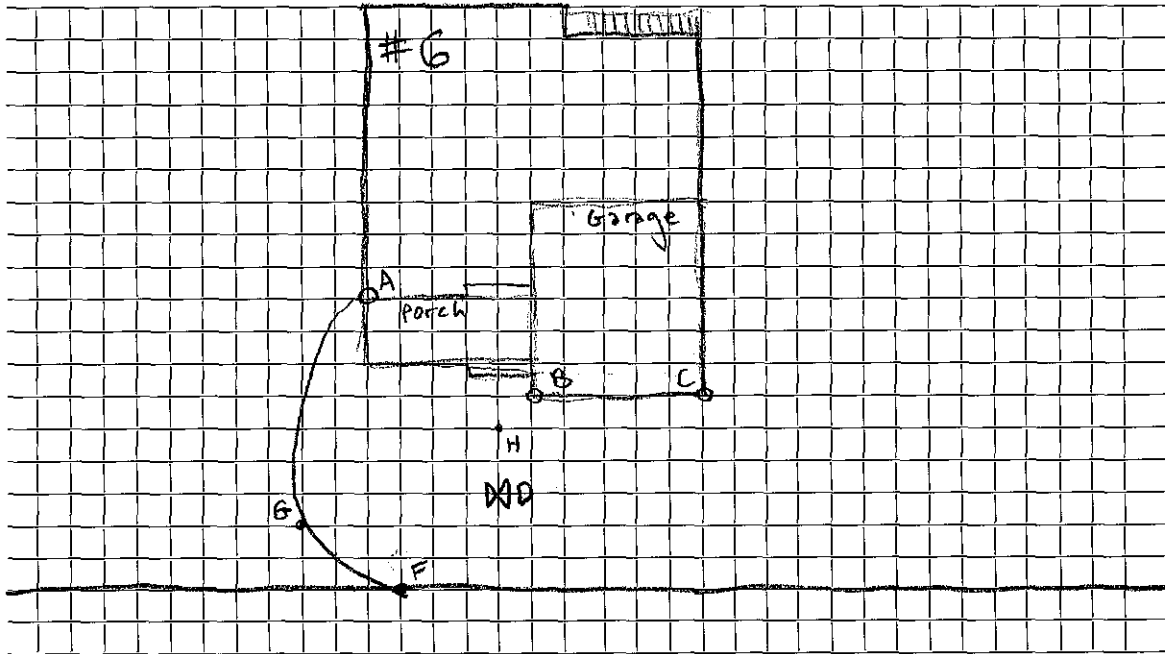

F = 1" curb stop
G = Bend around
infiltration unit

AF = 43'
CF = 61.8'
AG = 40'
CG = 67'
L ≈ 60'
D_{curb} = 5'

Connection made in (unknown) Street. Work completed

Remarks: Address + contractor + date unknown