

WATER SERVICE RECORD

Name Charles Whipple

Service No. 293

Address 1 Upland Road

Location

~~Repair—Renewal—Sewer Service~~


Comm 2-8-60

Date	Material	Amount	Total	Date	Amount
11-27-59	Labor	55 84		11-6-60	Deposit 125 00
	10% O. H.	5 58	61 42	2-8-60	Retard 25 15
40'	3/4" Copper tubing @.42		16 80		99 85
1	3/4" C x 1/2 I.W.H. Stop & Waste	5 88			NON CHARGE
3	Hrs. Town Shovel @4.50		13 50	11-27-59	Labor 6 99
3	Hrs. Trucking @.75		2 25	25'	3/4" Copper tubing @.42 10 50
			99 85	1	3/4" C Curb Cock 5 98
				1	3/4" Adapter 4 67
				1	Box & Rod 5 00
				1	1/2 Straight Tailpiece 50
				1	1/2 Offset Tailpiece 50
					22 x 3 Patch 22 00
					56 14

TOWN OF LEXINGTON — BOARD OF PUBLIC WORKS

WATER DIVISION

Sketch of Service Here

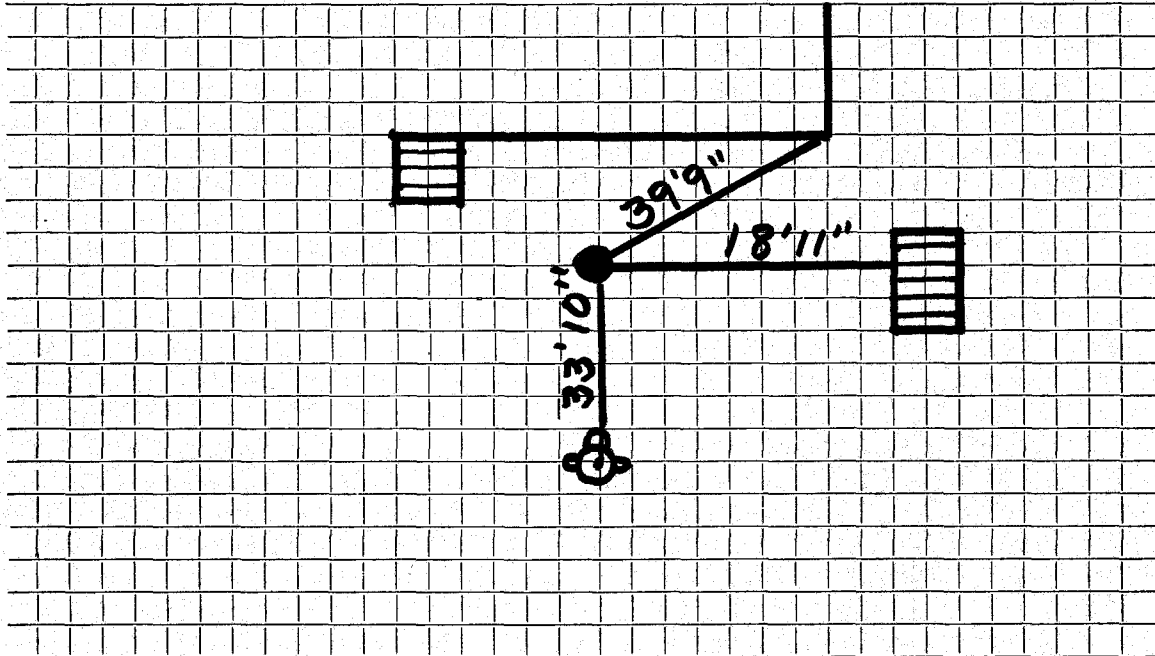

Connection made in Street. Work completed

Remarks:
.....
.....