

## WATER SERVICE RECORD

Name

Mrs Stewart

Service No. 28

Address

3 Upland Road

Location

~~Repair~~—Renewal—~~New Service~~

W.O. #2499

FEB 10 1975


Date	Material	Amount	Total	Date	Amount	
9-6-74	Labor	113 77		9-6-74	Deposit	350 00
	10% O.H.	11 38	\$125 15	2-10-75	Retund	137 45
51'	3/4" Copper Pipe @1.05		53 55			212 55
1	3/4 x 3/4 Stop & Waste		11 13	5-7-71		
1	3/4 x 1/2 Bushing		1 32		28' 3/4" Copper	
20	Yds. Loam @5.00		10 00		1 3/4" Corp. Cock	
2	Lbs. Seed @.95		1 90		1 3/4" Curb Cock	
1	Hr. Trucking @3.00		3 00		1 Box + Rod	
1	Hr. Town Shovel @6.50		6 50		1 1" repair Clamp	
			<u>\$212.55</u>		1 4" X 1" Nipple	
					1 1" C. To Iron Fitting	

DATE \_\_\_\_\_

TOWN OF LEXINGTON — BOARD OF PUBLIC WORKS

WATER DIVISION

Sketch of Service Here

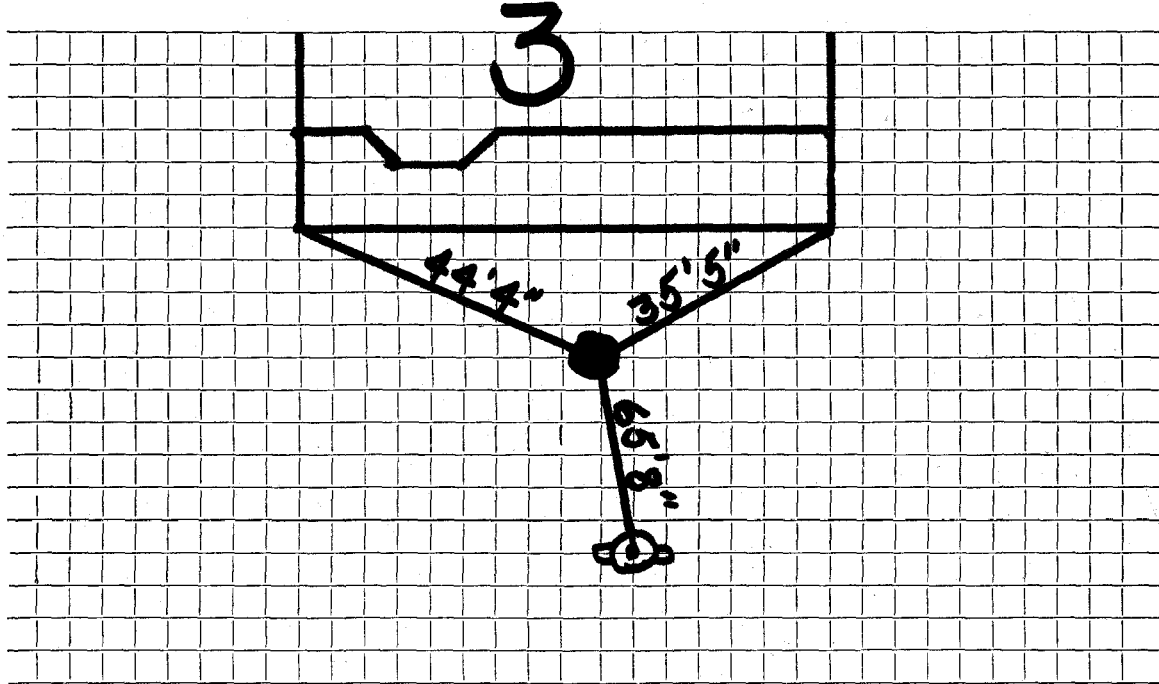

Connection made in ..... Street.      Work completed .....

Remarks: .....  
.....  
.....