

## WATER SERVICE RECORD

Name Margot Shaw

Service No. 2697

Address 4 Upland Road

Location

~~Repair—Renewal—New Service~~

W.O.#2093.

"outside"


Date	Material	Amount	Total	Date	Amount
5-15-74	Labor	\$48.52			
5-21-74	"	12.06	\$60.58		
	8' 3/4" Copper Pipe @1.05		8.40		
	1 3/4" Curb Cock		12.45		
	1 <del>1"</del> Repair Clamp		5.05		
	1 3/4" Adapter				
	1 <del>4" x 1"</del> Nipple		.51		
	1/2 Ton Cold Patch		3.05		
	1 Box & Rod		12.95		
	1 Patch 11' x 12'		87.96		
	2 1/2 Hrs. Trucking				
	3 Hrs. Town Shovel				
	1/2 Hr. Pick up				
	1/2 Hr. Loader				
	1/2 Hr. Compressor				
	INSIDE - James Redmond #3639				
6/3/81	26' 3/4" Copper tubing				

DATE \_\_\_\_\_

TOWN OF LEXINGTON — BOARD OF PUBLIC WORKS

WATER DIVISION

Sketch of Service Here

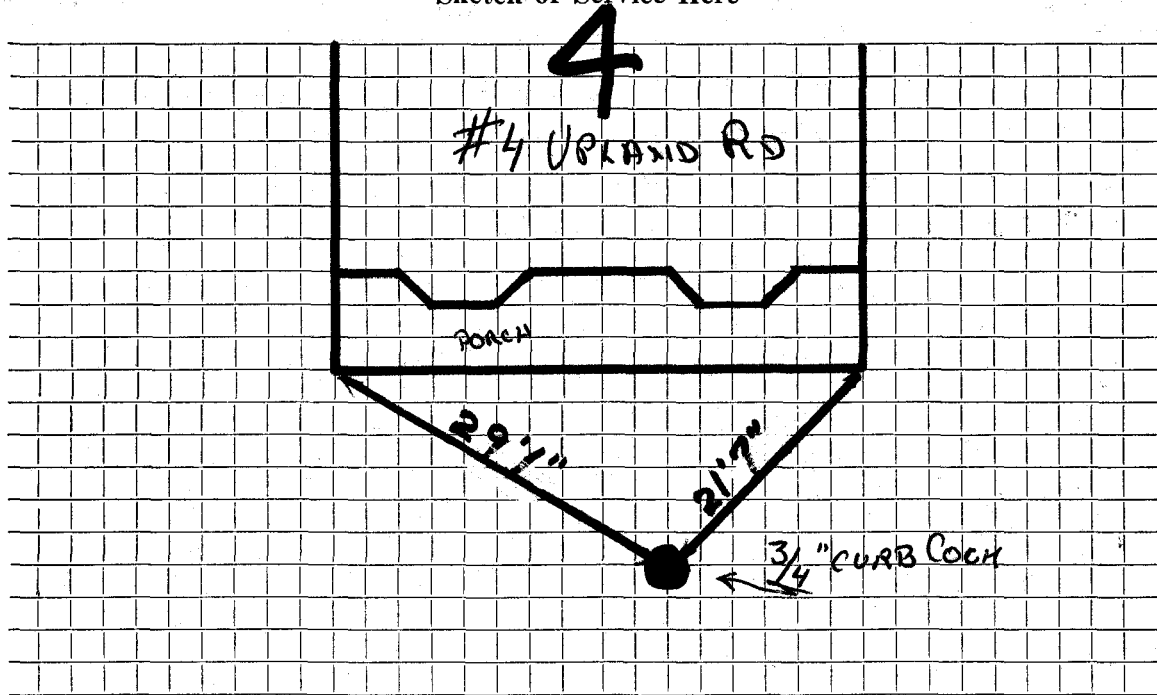

Connection made in ..... Street.                      Work completed .....

Remarks: .....  
.....  
.....