

Name Arthur J. Pennell

Service No. <sup>#3756</sup> 2698

Address 6 Upland Road

74

Location *6 Upland Road.*

Kind of Pipe

Size

Size of Main

~~\*\*Repair—Renewal—New Service~~ #7606

Location JAN 27 1969

Date	Material	Amount	Total	Date	Amount
11/13/68	Labor	36 63		11-1-68	200 00
11/15/68	"	16 26		1-23-69	87 89
	10% O.H.	5 29	58 18		112 11
22'	3/4" Copper tubing		17 38	11/13/68	
1	3/4" Wheel Valve		9 30	10'	Labor
1	Yd. Loam		3 50	1	3/4" Copper tubing
1/2	Ton Cold Patch @ 5.50		2 75	1	3/4" Corporation
2	Hrs. Trucking @ 3.00		6 00	1	3/4" Curb cock
2	" Shovel @ 6.50		13 00	1/2	Ton cold patch @ 5.50
1/4	" Roller @ 3.00		75	2	Hrs. Trucking @ 3.00
1/4	" Compressor @ 5.00		1 25	2	" Shovel @ 6.50
			112 11	1/4	" Roller @ 3.00
				1/4	" Compressor @ 5.00
	Labor				105 43

*Deposit*  
*Refund*  
Outside

Hadley Press, Inc., Lexington

DATE \_\_\_\_\_

# TOWN OF LEXINGTON—BOARD OF PUBLIC WORKS

## WATER DIVISION.

The undersigned applies for a supply of water at No. \_\_\_\_\_ St. and hereby agrees to comply with the rules and regulations as now, or at any future time, established by the Board of Selectmen.

Am't. of Estimate \$ \_\_\_\_\_

Owner

f. D. Cloyer.


Am't. Paid \$ \_\_\_\_\_

Address

6 Upland Rd.

Builder \_\_\_\_\_

Sketch of Service Here

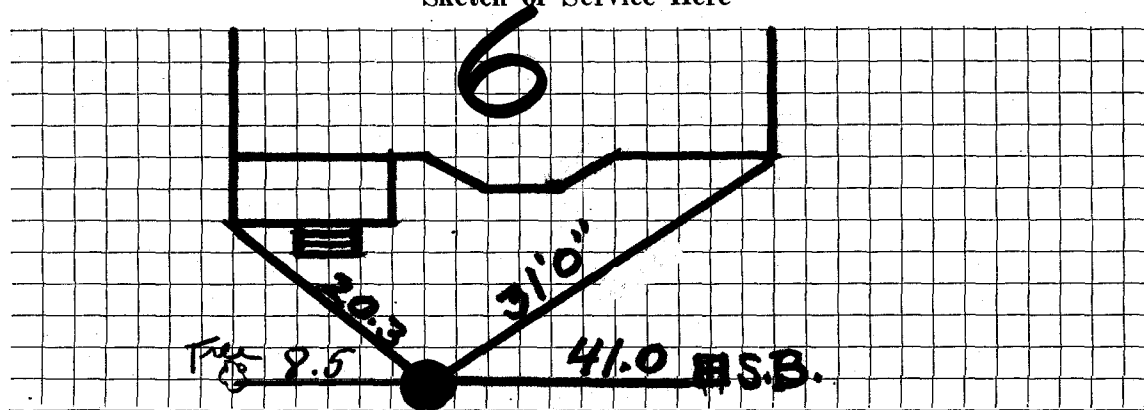

Connection made in \_\_\_\_\_ Street.

Work completed \_\_\_\_\_ 19

Remarks: