

WATER SERVICE RECORD

Name John E. Kelley

Service No. 1118

Address ~~138 Waburn Street~~

Maybe #1 Utica St

Location

Equip: ~~Water Service~~

Conn. F-3054

Lot 75


Date	Material	Amount	Total	Date	Amount
7/14/54	Labor	2 00		6-28-54 Deposited	25 00
	10% overhead	20	2 20	6-30-54 Refunded	(6 85)
	32'-3/4" Copper Tubbing @.35		11 20		NON CHARGE
	1-3/4 C x 1/2 I.W.H. stop & waste	4 00		7/14/54 Labor	2 00
	1 hr. Trucking		75	2'-3/4" Copper Tubing @.35	8 10
			18 15	1-3/4" C. Corp. Cock	4 33
				1-3/4" C x 3/4" C Curb-cock	4 67
				1 Box and Rod	3 90
				1-1/2 Straight Tail Piece	50
				1-1/2 offset tail piece	50
				1 hr. Trucking	75
					25 05
				Taped on 16" Water Main	

DATE _____

TOWN OF LEXINGTON — BOARD OF PUBLIC WORKS

WATER DIVISION

Sketch of Service Here

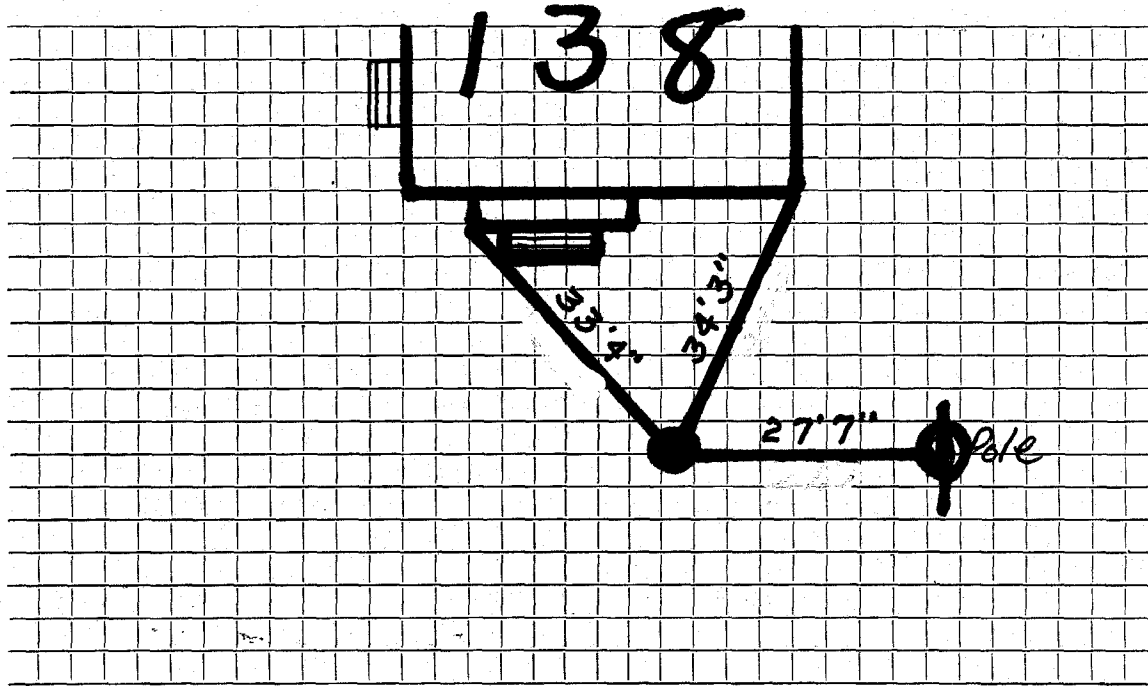

Connection made in Street. Work completed

Remarks: ON 16" WATER MAIN