

# WATER SERVICE RECORD

Name


Service No.

Address 11 UTICA ST

Location

LOT 72

Repair—Renewal—New Service

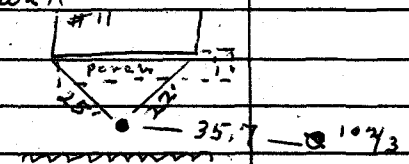
Date		Material	Amount	Total	Date	Def. l/c	Amount
10/30/57	28'	3/4 Copper			Sept 07	5' 1" Copper	
						1 1" Corp	
						1 1" Curb STOP	
						1 1" x 3/4 Reducer	
						baffle box	
						old 3/4 Curb left IN place	
						behind Wall	
							

DATE \_\_\_\_\_

TOWN OF LEXINGTON — BOARD OF PUBLIC WORKS

WATER DIVISION

Sketch of Service Here

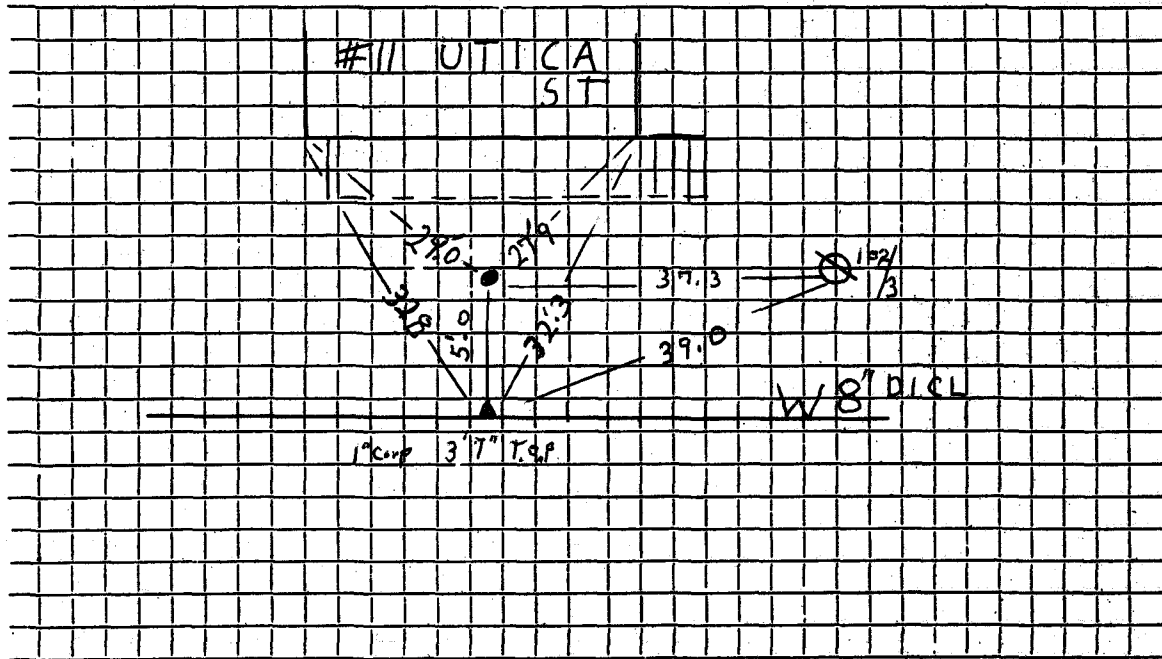

Connection made in ..... Street. Work completed .....

Remarks: old 3/4 Curb 1 c.f. in place behind wall .....

